

Administrative Approval Action

Case File / Name: ASR-0087-2021 DSLC - 2510 Hillsborough St. Revitalization

City of Raleigh
Development Services Department
One Exchange Plaza
Raleigh, NC 27602
(919) 996-2492
currentplanning@raleighnc.gov
www.raleighnc.gov

LOCATION: This .19 acre site zoned NX-7-SH-CU is located on the north side of Hillsborough

Street, west of the intersection of Hillsborough and Horne Street at 2510

Hillsborough Street.

REQUEST: This is an 18,141 gross square foot mixed use building (restaurant, bar, and retail

establishment).

DESIGN

ADJUSTMENT(S)/

ALTERNATES, ETC: N/A

FINDINGS: City Administration finds that this request, with the below conditions of

approval being met, conforms to the Unified Development Ordinance. This approval is based on a preliminary plan dated April 13, 2022 by Pabst

Design Group, PA.

CONDITIONS OF APPROVAL and NEXT STEPS:

This document must be applied to the second sheet of all future submittals except for final plats. This is a preliminary plan and as such no permits have been issued with this approval. To obtain permits and/or completion of the project, the following steps are required:

☑ <u>SITE PERMITTING REVIEW</u> - For land disturbance of 12,000 square feet or greater, public or private infrastructure, shared stormwater devices, etc. Site Permitting Review may be submitted upon receipt of this signed approval document.

The following items are required prior to approval of Site Permitting Review plans:

Engineering

 A Traffic Control and Pedestrian (TCPED) Plan must be approved and a right-of-way occupancy permit must be obtained from Right-of-way Services for any construction activities within the right-of-way.

Public Utilities

2. The water meters must be proposed in a location acceptable to the City of Raleigh Public Utilities Department.

☑ <u>BUILDING PERMITS</u> - For buildings and structures shown on the approved plans. Commercial building permit plans must include the signed, approved Site Permitting Review plans attached, if applicable. Permit sets may be reviewed prior to the recordation of required plats, but cannot be approved.

The following items must be approved prior to the issuance of building permits:

General

1. The final location for the GOTriangle Bus stop is coordinated with the Transit Division and all accommodations are in place to install the infrastructure for the bus stop.



Administrative Approval Action

Case File / Name: ASR-0087-2021 DSLC - 2510 Hillsborough St. Revitalization

City of Raleigh **Development Services Department** One Exchange Plaza Raleigh, NC 27602 (919) 996-2492 currentplanning@raleighnc.gov www.raleighnc.gov

- Revise the plan taking advantage of Text change TC-11-21 (Maximum parking limits). (FYI - TC-11-21 went into effect recently limiting parking to a maximum number as opposed to a minimum requirement.) Should you wish to utilize this recently effective text change please note this on the cover sheet and remove sheet C-2.2.
- 3. Comply with all conditions of Z-2-14

Engineering

A Traffic Control and Pedestrian (TCPED) Plan must be approved and a right-of-way occupancy permit must be obtained from Right-of-way Services for any construction activities within the right-of-way.

Public Utilities

5. A plat must be recorded at the Wake County Register of Deeds office for all utility easement dedications.

Urban Forestry

- 6. A tree impact permit must be obtained for the approved streetscape tree installation in the right of way. This development proposes (3) street trees along Hillsborough St.
- 7. A public infrastructure surety for (3) tree pit street trees shall be provided to City of Raleigh Transportation - Development Engineering Division (UDO 8.1.3) in the amount of 100% of the improvement cost for the NCDOT portion and 125% of the improvement cost for the City of Raleigh infrastructure.

EXPIRATION DATES: The expiration provisions of UDO Section 10.2.8 E, including the ability to request extensions in the expiration date, apply to this site plan. If significant construction has not taken place on a project after administrative site review approval, that approval may expire and be declared void, requiring re-approval before permits may be issued. To avoid allowing this plan approval to expire the following must take place by the following dates:

3-Year Expiration Date: September 22, 2025

Obtain a valid building permit for the total area of the project, or a phase of the project.

4-Year Completion Date:

Within four years after issuance of the first building permit for the site plan, the construction of the entire site plan must be completed unless an applicant has been granted vested rights. Failure to complete construction within this specified time frame shall automatically void the approved site plan for which no building permits have been issued.



I hereby certify this administrative decision.

Administrative Approval Action

Case File / Name: ASR-0087-2021 DSLC - 2510 Hillsborough St. Revitalization City of Raleigh
Development Services Department
One Exchange Plaza
Raleigh, NC 27602
(919) 996-2492
currentplanning@raleighnc.gov
www.raleighnc.gov

Signed:	Daniel L. Stegall	Date:	05/26/2022
	Development Services Dir Designee	_	
Staff Coord	inator: Michael Walters		

	BUILDING DATA	
SITE DATA Zoning district (if more than one, please provide the acreace of each):	Existing gross floor area (not to be demolished): N/A	
Neighborhood Mixed Use (NX-7-SH-CU)	Existing gross floor area to be demolished: N/A	
Gross site acreage: 0.186 AC	New gross floor area: 18,141 GFA	
# of parking spaces required: 23	Total of gross (to remain and new): 18,141 GFA	
# of parking spaces proposed: 23 (Remote)	Proposed # of buildings: 1	
Overlay District (if applicable): special Residential Parking Overlay District	Proposed # of stories for each: 2	
Existing use (UDO 6.1.4): Vacant		
Proposed use (UDO 6.1.4): Eating Establishment, bar, retail sales		
STORMWATER	INFORMATION	
Existing Impervious Surface:	Proposed Impervious Surface:	
Acres: 180 AC Square Feet: 6,100 SF	Acres: NA Square Feet: NA	
Is this a flood hazard area? Yes No 🗹 If yes, please provide:		
Flood study: 3720079400J select May 2, 2006		
FEMA Map Panel #: PROUSE River Buffer Yes No	Wetlands Yes No ✓	
Nouse river bullet 185 V NO	Westing 165 No P	
RESIDENTIAL DE	VELOPMENTS	
Total # of dwelling units: N/A Total # of hotel units: N/A		
# of bedroom units: 1br 2br 3br 4br or more		
# of lots:	Is your project a cottage court? Yes No	
SIGNATUR	E BI OCK	
The undersigned indicates that the property owner(s) is award described in this application will be maintained in all respects herewith, and is accordance with the provisions and regulatic II, Mark Phillips, PLA will se and respond to administrative comments, resubmit plans and respond to administrative comments, resubmit plans and owner(s) in eary public meeting regarding this application.	In accordance with the plans and specifications submitted nes of the City of Raleigh Unified Development Ordinance. In the specific of the specific of the specific of the specific applicable documentation, and will represent the property	
I/we have read, acknowledge, and affirm that this project is o proposed development use. I acknowledge that this application will expire after 180 days of inactivity.		
proposed development use. I acknowledge that this applicati		


FOR REVIEW ONLY

NOT FOR CONSTRUCTION

TIER 3 SITE PLAN REVIEW FOR:

2510 HILLSBOROUGH STREET REVITALIZATION

RALEIGH, NORTH CAROLINA

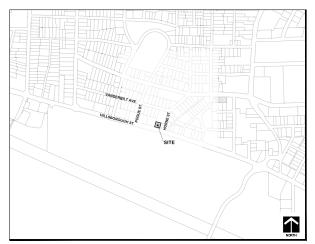

VICINITY MAP 1"=500'

STREETSCAPE ELEMENTS INDEX TO PLANS MAINTAINED BY THE CITY:

STREET TREES TREE GRATES TREE GRATES
CURB AND GUTTER
STREET PAVING
CROSSWALK STRIPING AND SIGNALS
BUS STOPS
ON-STREET PARKING STRIPING

MAINTAINED BY THE LANDOWNER: BUSINESS SIGNS LIGHTING

COVER SHEET
ASBUILT SURVEY
EXISTING CONDITIONS & DEMOLITION PLAN SITE LAYOUT PLAN GROUND FLOOR STREETSCAPE PLAN REMOTE PARKING PLAN LITH ITY PLAN GRADING AND DRAINAGE PLAN SITE DETAIL SHEET UTILITY DETAIL SHEET STORM DRAINAGE DETAIL SHEET LANDSCAPE PLAN LANDSCAPE DETAIL SHEET BASEMENT FLOOR PLAN
GROUND FLOOR PLAN
SECOND FLOOR PLAN

DEVELOPER: CITYPLAT MODALIA 2510, LLC 2021 FAIRVIEW RD RALEIGH, NC 27608 TEL: 724.549.5916 EMAIL: pat@citvplat.com

CIVIL ENGINEER: PABST DESIGN GROUP, PA EMAIL: dpabst@pabstdesign.com SURVEYOR: NEWCOMB LAND SURVEYORS, LLC 7008 HARPS MILL RD, STE. 105 RALEIGH, NC 27615 TEL: 919.847.1800 EMAIL: justin@nls-nc.com

ARCHITECT: NEW CITY DESIGN GROUP TEL: 919.831.1308 EMAIL: Jeff@newcitydesign.com

······ Mario

LIMITED USE STANDARDS PER UDO 6.4.10 B:

NO LIVE PERFORMANCES
NO DANCE FLOOR
OUTDOOR SEATING IN EXCESS OF 20 SEATS SHALL REQUIRE

a) THE OUTDOOR SEATING AREA SHALL BE A MINIMUM DISTANCE OF 100 FEET FROM ANY PRINCIPAL OR ACCESSORY DWELLING UNIT IN A RESIDENTIAL DISTRICT; HOWEVER

b) THE MINIMUM DISTANCE MAY BE REDUCED TO 40 FEET PROVIDED:

ROVIDED:

1) A TYPE B1 TRANSITIONAL PROTECTIVE YARD IS ESTABLISHED ALONG ANY SHARED PROPERTY LINE LOCATED BETWEEN THE ANY APPLICABLE PRINCIPAL, OR

3) NOTHING IN THIS SUBSECTION SHALL BE CONSTRUED TO REQUIRE SCREENING OR LANDSCAPING ALONG A PROPERTY LINE OR RIGHT-OF-WAY LINE WHEREIN THE OUTDOOR SEATING AREA IS SCREENED WHOLLY AND ADEQUATELY BY A NON-RESIDENTIAL PRINCIPAL STRUCTURE, EITHER ON SITE OR

COMPLIANCE WITH LIMITED USE STANDARDS

- LIVE PERFORMANCES WILL NOT BE HELD.
 A DANCE FLOOR HAS IS NOT PROPOSED.
 A DANCE FLOOR HAS IS NOT PROPOSED ON 2ND LEVEL AND SCREENED BY PRINCIPAL STRUCTURE ON-SITE FROM ADJUNCELING UNITS.
 OUTDOOR SEATING TO BE APPROVED AS PART OF THIS

EXEMPTION NOTES:

2001 FAINTEW ROAD
RALEIDIN, NO 2708
BK 01986, FO 00008
BK 01986, FO 00008
BK 01986, FO 00008
BK 01986, FO 00008
BK 01986, FO 0198 ACO
BK 0 SPECIAL RESIDENTIAL PARKING OVERLAY DISTRICT (-SRPOD)
THE PROPERTY IS NOT LOCATED IN A SPECIAL FLOOD HAZARD ZONE PER FLOOD INSURANCE RATE MAP 3729079400J, DATED MAY 2, 2006.
NONE PRE-DEVELOPED IMPERVIOUS: 8,100 SF (0.186 AC) POST-DEVELOPED IMPERVIOUS AREA: REQUIRED: 810 SF (10% OF TOTAL SITE AREA)
PROVIDED: 810 SF AT GROUND LEVEL CONTIGUOUS TO PUBLIC SW (10%) SHOPFRONT (-SH)
7 STORIES
PRIMARY STREET (MIN): 5'
SIDE STREET (MIN): 5'
SIDE STREET (MIN): 0' OR 6'
SIDE LOT LINE: 0' OR 6' FRONTAGE TYPE: PRIMARY REQUIRED: (MINIMAX): 0'/15' (80% WIDTH MIN.)
PRIMARY PROVIDED: 98.57% WIDTH STREETSCAPE WIDTH (MAX): 35° SIDEWALK (MIN): 6" BUILDING FLOOR AREA: BAR = 4,238 SF DAR = 4,238 SF
GROUND FLOOR LEVEL:
EATING ESTABLISHMENT = 6,301 SF
RETAIL = 198 SF
2ND FLOOR LEVEL:
BAR = 7,404 SF BUILDING GROSS FLOOR AREA = 18,141 SF GROUND FLOOR LEVEL (EATING ESTABLISHMENT) - 30 SEATS 2ND FLOOR OPEN-AIR PATIO (BAR) - 20 SEATS TOTAL OUTDOOR SEATING: 50 SEATS GROUND FLOOR: EXEMPT PER 7.1.3 C.4 PER 7.1.3 C.3 1 SPACE PER 500 SF OF NONRESIDENTIAL GROSS FLOOR AREA 11,642 SF / 500 = 23 SPACES 11,842 SF / 9509 = 23 SPAULS 2ND FLOOR UNCOVERED OUTDOOR SEATING AREA: EXEMPT PER 7.1.3 C.8 423117.943 (GFA OF RESTAURANT/BAR USES ON ALL LEVELS) = 2.91% REFER TO SHEET C-2.2

EATING ESTABLISHMENT/BAR: 1 SHORT TERM SPACE PER 50,000 SF OF GROSS FLOOR AREA AND 1 LONG TERM SPACE PER 25,000 SF OF GROSS GROSS FLOOR AREA AND I LONG TERM SPACE PER 25,000 SF OF GRO FLOOR AREA, MERIMAN OF 4 17,943 15,000 -0 (SHORT TERM) 17,943 15,000 -1 (SHORT TERM) 17,943 15,000 -1 (SHORT TERM) 19,943 15,000 -0 (SHORT TERM) 19,953 15,000 -0 (SHORT TERM) 19,953 15,000 -0 (SHORT TERM) 10,754 15,000 -0 (SHORT TERM)

CONDITIONS OF Z-2-14:

- THE FOLLOWING USES SHALL BE PROHIBITED: TELECOMMUNICATION TOWER ALL TYPES; DETENTION CENTER, JAIL, PRISON; TATTOO PARLOR, BODY PIERCING, EMERGENCY, SHELTER; OUTDOOR SPORTS AND ENTERTAINMENT FACILITY ALL TYPES; VEHICLE REPAIR MINOR).
- THE MAXIMUM BUILDING HEIGHT OF ANY BUILDING ON THE PROPERTY SHALL BE 7 STORIES/75 FEET IN HEIGHT, AS MEASURED BY UDD SECTION 1.5.7.
- THERE SHALL BE NO BALCONIES THAT ARE ASSOCIATED WITH INDIVIDUAL DWELLING UNITS CONSTRUCTED ON THE MORTHERN BUILDING FAÇADE FACING THAT ADJACENT TRACT OF LAND DESCRIBED AS PIRBST TRACT IN THAT CERTAIN DEED RECORDED IN BOOK 4103, PAGE 41, WAKE COUNT
- ALL POLE MOUNTED LIGHTING LOCATED BETWEEN THE PRINCIPAL BUILDING AND THE MORTHERN PROPERTY LINE SHALLS BE OF PULL CUT-OFF DESIGN, AND ALL LIGHT FRIVINGS MOUNTED ON THE EXTENSIOR OF THE MOORTH FACADE, OF THE PRINCIPAL BUILDINGS SHALL BE OF PULL CUT-OFF DESIGN. THE EXTENSIOR OF THE REQUIRED BY OUTDOOR AMENITY AREA SHALL BE LOCATED CONTIQUIOUS TO THE RIBLIO SERVALK.
- THE BUILDING FACADE FACING HILLSBOROUGH STREET SHALL PR VARIATION (RECESS OR PROTRUSION) OF AT LEAST EIGHTEEN INCHES (19*) IN DEPTH AT LEAST TWICE ALONG THE THAT FAÇADE, ALSO, THE BUILDING FAÇADE FACING HILLSBOROUGH STREET SHALL HOODPOPARTA T LEAST TWO CHANGES IN BUILDING MATERIALS AND AT LEAST ONE CANDPY.
- AN AREA MEASURING AT LEAST 700 SQUARE FEET IN FLOOR AREA SHALL BE PROVIDED ON THE GROUND LEVEL OF THE BUILDING FOR HON-RESIDENTIAL USE, AND THIS AREA SHALL BE DIRECTLY ACCESSIBLE AN ADOSE LOCATE OUT THE NORTH SIDE OF THE BUILDING FAUNCH THAT ADJACENT TRACT OF LAND DESCRIBED AS "FIRST TRACT" IN THAT CERTAIN DEED RECORDED IN BOOK 4153 PAGE 41, WAKE COUNTY

COMPLIANCE WITH CONDITIONS OF Z-2-14:

THERE ARE NOT INDIVIDUAL DWELLING UNITS PROPOSED WITH THIS ADMINISTRATIVE SITE REVIEW

- PER AGENTICTURAL ELEVATIONS AND FLOOR PLANS, ALL LIGHT FIXTURES MOUNTED ON THE EXTERIO OF THE HORTH FACOGO OF THE REPORT FACOGO OF THE FACOGO OF THE REPORT FACOGO OF THE REPORE FACOGO OF THE REPORT FACOGO OF THE REPORT FACOGO OF THE REPORT
- A 700 SQUARE FOOT FLOOR AREA IS PROVIDED ON THE GROUND LEVEL OF THE BUILDING FOR NON-RESIDENTIAL USE, AND THIS AREA IS DIRECTLY ACCESSIBLE BY A DOOR LOCATED ON THE NORTH SIDE OF THE BUILDING FACING THAT DAILOCKET TRACT OF LAND.

SITE DATA TABLE 2510 HILLSBOROUGH STREET RALEIGH, NC 27607 CITYPLAT MODALIA 2510, LLC 2021 FAIRVIEW ROAD

GOU,

REVITALIZATION

ST.


HILLSBOROUGH

220

RALEIGH, WARE COUNTY, MORTH CAROLUMA
TIER 3 ADMINISTRATIVE SITE REVIEW PLANS
COVER SHEET

C-0.0

PROJECT NUMBE 581-21

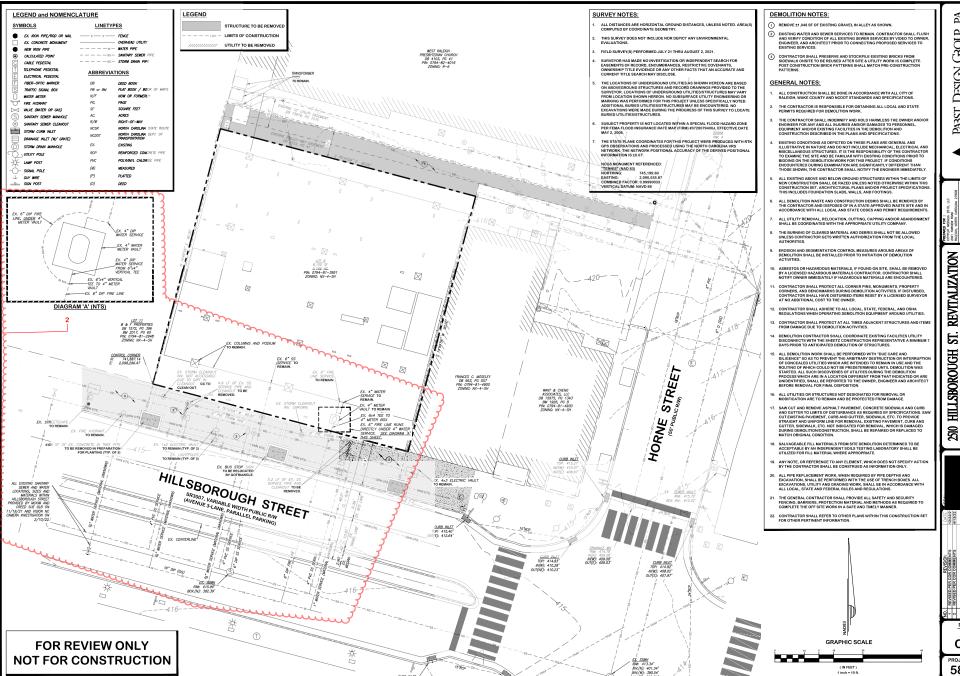


GOUP, DESIGN

PASST


RALEIGN, WARE COUNTY, ROPITH CAROLINA
TIER 3 ADMINISTRATIVE SITE REVIEW PLANS
EXISTING CONDITIONS & DEMOLITION PLAN


C-1.0 PROJECT NUMBER


581-21

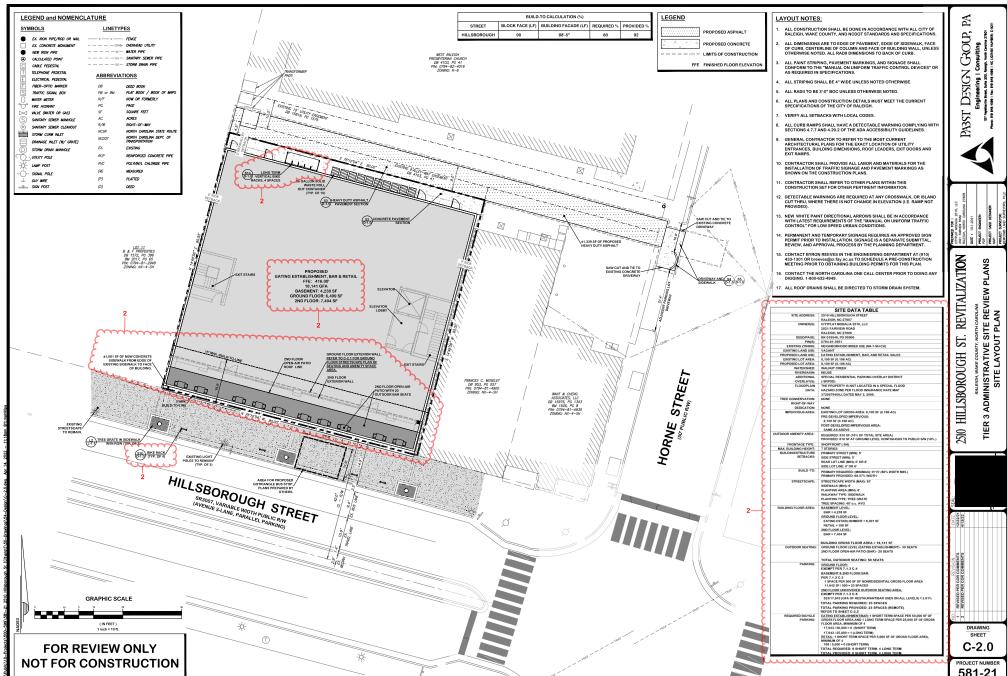

581-21

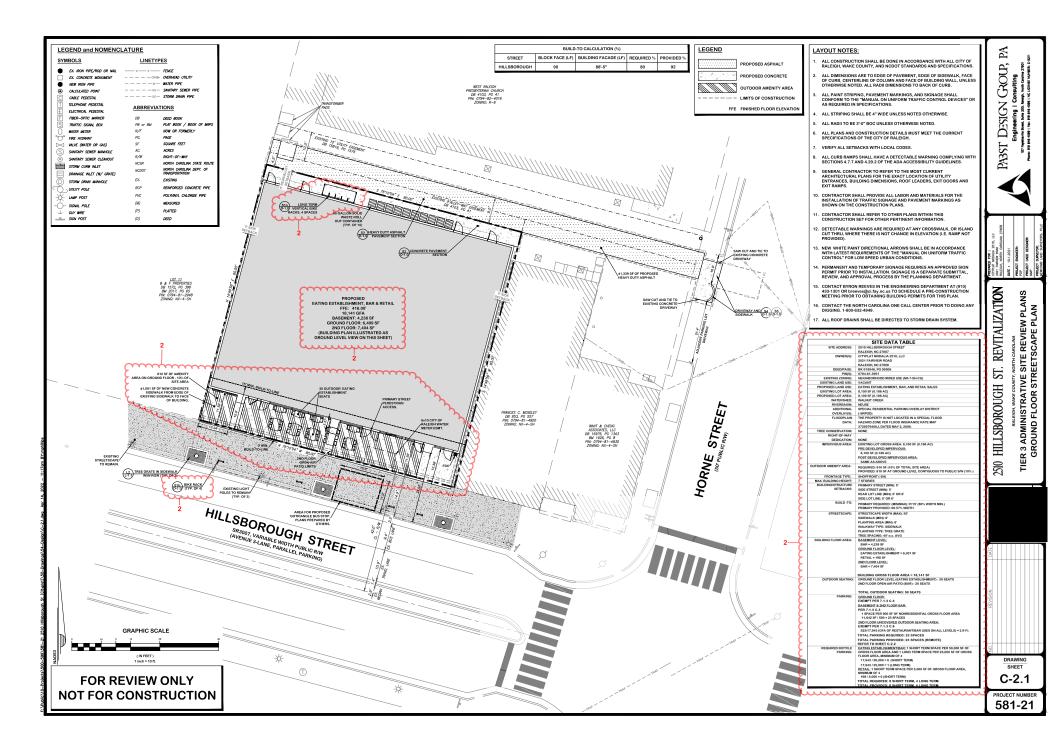

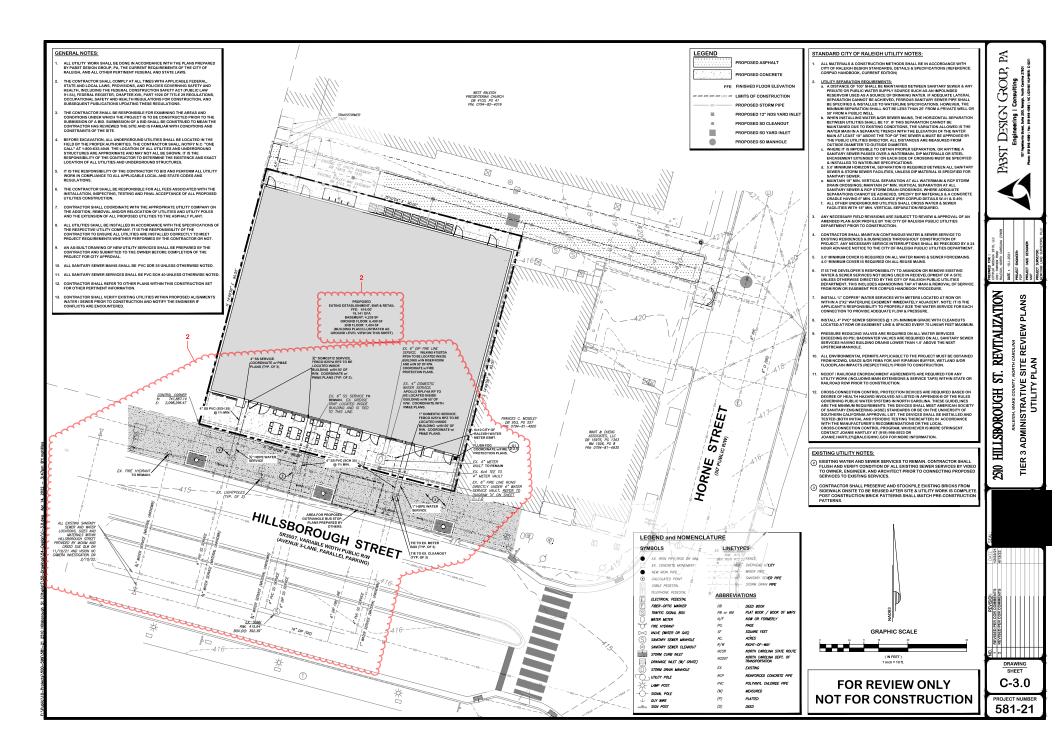

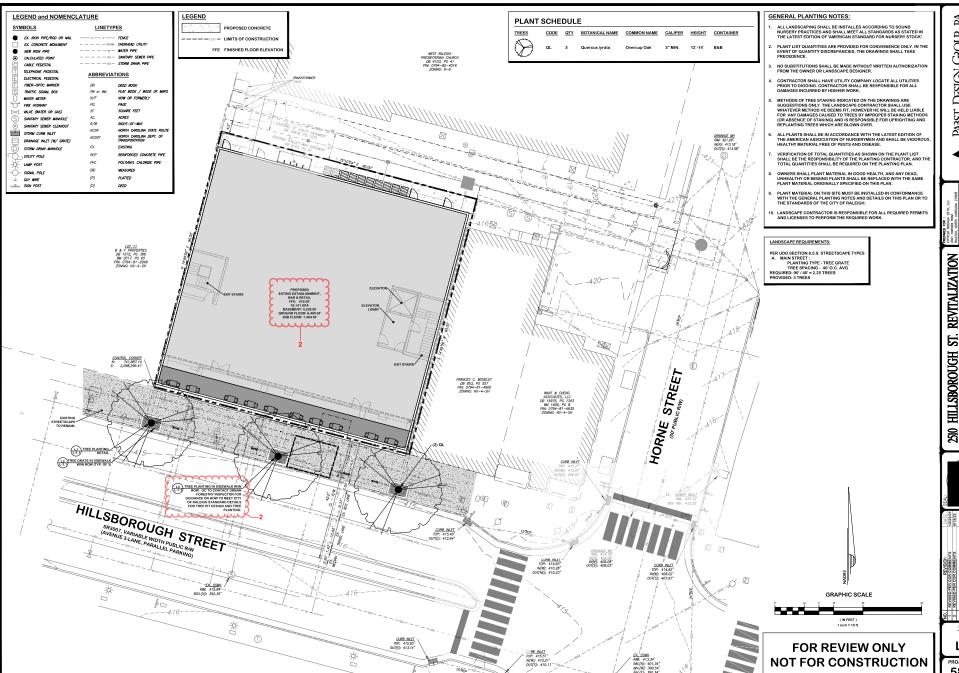

GOU, DESIGN **PASST**

RALEIGH, WARE COUNTY, MORTH CAROLUMA
TIER 3 ADMINISTRATIVE SITE REVIEW PLANS
LANDSCAPE PLAN

DRAWING SHEET

L-1.0

PROJECT NUMBER 581-21

