

Administrative Approval Action

Case File / Name: ASR-SR-22-2019 Bowstring Bar City of Raleigh
Development Services Department
One Exchange Plaza
Raleigh, NC 27602
(919) 996-2492
currentplanning@raleighnc.gov
www.raleighnc.gov

LOCATION: REQUEST:

The site is located at 1930 Wake Forest Road and the PIN is 1714184795.

This is a proposed change of use for an existing building. The applicant is proposing 3,387 square feet of gross floor area within the existing building and additional outdoor seating as a bar. The site will adhere to Unified Developement Ordinance (UDO) Section 6.4.10 as a bar and is permitted in an Industrial Mixed Use zoning district with a Parking Limited Frontage (IX-3-PL). 7,450 square feet of

warehouse space is located in a separate building on site.

A Design Adjustment was requested under case A-94-19 and approved by the Board of Adjustment on July 8/2019. The applicant requested a 6,120 foot design adjustment from the 4,000 foot maximum block perimeter requirements set forth in UDO Section 8.3.2.A. of the Unified Development Ordinance that results in a block perimeter of 10,120 feet and a design adjustment for complete relief from the cross-access requirements set forth in UDO Section 8.3.5.D.

DESIGN
ADJUSTMENT(S)/
ALTERNATES, ETC:

SPR-0221-2019: DSLC - Site Permitting Review/Major [Signature Set]

FINDINGS:

City Administration finds that this request, with the below conditions of approval being met, conforms to the Unified Development Ordinance. This approval is based on a preliminary plan dated September 12, 2019 by FLM

Engineering.

CONDITIONS OF APPROVAL and NEXT STEPS:

This document must be applied to the second sheet of all future submittals except for final plats. This is a preliminary plan and as such no permits have been issued with this approval. To obtain permits and/or completion of the project, the following steps are required:

☑ <u>SITE PERMITTING REVIEW</u> - For land disturbance of 12,000 square feet or greater, public or private infrastructure, shared stormwater devices, etc. Site Permitting Review may be submitted upon receipt of this signed approval document.

The following items are required prior to approval of Site Permitting Review plans:

Engineering

- 1. A right-of-way obstruction permit must be obtained from Right-of-way Services prior to the commencement of any construction activities within the right-of-way.
- 2. Required NCDOT encroachment and/or driveway permits must be approved and copies provided to Development Services Development Engineering prior to concurrent review approval.

☑ <u>BUILDING PERMITS</u> - For buildings and structures shown on the approved plans. Commercial building permit plans must include the signed, approved Site Permitting Review plans attached, if applicable. Permit sets may be reviewed prior to the recordation of required plats, but cannot be approved.

The following items must be approved prior to the issuance of building permits:



Administrative Approval Action

Case File / Name: ASR-SR-22-2019 Bowstring Bar City of Raleigh
Development Services Department
One Exchange Plaza
Raleigh, NC 27602
(919) 996-2492
currentplanning@raleighnc.gov
www.raleighnc.gov

Engineering

- 1. A right-of-way obstruction permit shall be obtained from Right-of-way Services for any construction activity within the right-of-way.
- 2. Required NCDOT encroachment and/or driveway permits must be approved and copies provided to Development Services Development Engineering.
- 3. A fee-in-lieu for 6' in sidewalk width across the entire Wake Forest Road frontage shall be paid to the City of Raleigh (UDO 8.1.10).
- 4. A fee-in-lieu for (2) street trees shall be paid to the City of Raleigh (UDO 8.1.10).
- 5. A slope easement and associated deed of easement shall be approved by the City and the location of the easement shall be shown on a map approved for recordation. The deed of easement shall be recorded at Wake County Register of Deeds within one day of recordation of the recorded plat. A recorded copy of these documents must be provided to the Development Services Department within one day from authorization of lot recordation. If recorded copies of the documents are not provided, further recordings and building permit issuance will be withheld.
- 6. The required right of way for proposed and/or existing streets shall be dedicated to the City of Raleigh and is shown on a plat approved for recordation.
- 7. A 5' utility placement easement and associated deed of easement shall be approved by the City and the location of the easement shall be shown on the map approved for recordation. The deed of easement shall be recorded at Wake County Register of Deeds within one day of recordation of the recorded plat. A recorded copy of this document must be provided to the Development Services Department within one day from authorization of lot recordation. If a recorded copy of the document is not provided within this time, further recordings and building permit issuance will be withheld.

Public Utilities

- 8. A plat must be recorded at the Wake County Register of Deeds office for all utility easement dedications.
- 9. Infrastructure Construction Plans (concurrent submittal) must be approved by the City of Raleigh Public Utilities Department for all public water, public sewer and/or private sewer extensions.

The following are required prior to issuance of building occupancy permit:

General

1. Required public right-of-way infrastructure improvements shall be, at a minimum, sufficiently completed to provide the necessary, safe emergency and vehicular access.

EXPIRATION DATES: The expiration provisions of UDO Section 10.2.8 E, including the ability to request extensions in the expiration date, apply to this site plan. If significant



Administrative Approval Action

Case File / Name: ASR-SR-22-2019 Bowstring Bar City of Raleigh
Development Services Department
One Exchange Plaza
Raleigh, NC 27692
(919) 996-2492
currentplanning@raleighnc.gov
www.raleighnc.gov

construction has not taken place on a project after administrative site review approval, that approval may expire and be declared void, requiring re-approval before permits may be issued. To avoid allowing this plan approval to expire the following must take place by the following dates:


3-Year Expiration Date: September 24, 2022

Obtain a valid building permit for the total area of the project, or a phase of the project.

4-Year Completion Date:

Within four years after issuance of the first building permit for the site plan, the construction of the entire site plan must be completed unless an applicant has been granted vested rights. Failure to complete construction within this specified time frame shall automatically void the approved site plan for which no building permits have been issued.

I hereby certify this administrative decision.		
Signed:	Date:	09/25/2019
Development Services Dir/Designee		
Staff Coordinatory Daniel Stegall		

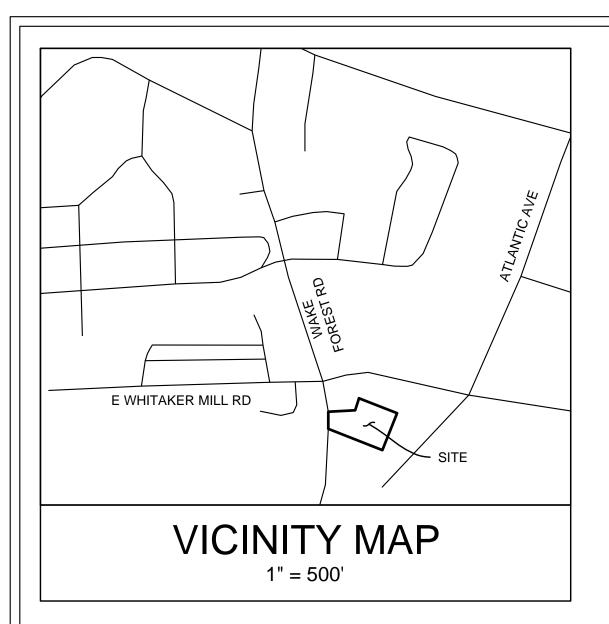

SUMMARY INFORMATION

DEVELOPMENT NAME: BOWSTRING BAR

STREET ADDRESS: 1930 WAKE FOREST ROAD

ADMINISTRATIVE SITE PLANS FOR BOWSTRING BAR

1930 WAKE FOREST ROAD RALEIGH, NORTH CAROLINA 27608 PIN: 1714-18-4795 TRANS. # 589608 ASR-SR-22-19

PIN NUMBER: 1714-18-4795 **TOTAL ACREAGE:** 1.29 AC (56,126 SF) LESS R/W DEDICATION: 0.05 AC (2,014 SF) **NET AREA:** 1.24 AC (54,112 SF) JURISDICTION: CITY OF RALEIGH **ZONING DISTRICT**: IX-3-PL **EXISTING USE:** LIGHT INDUSTRIAL PROPOSED USE: BAR PL PRIMARY STREET MAXIMUM BUILD-TO: 100' PROPOSED PRIMARY STREET BUILD-TO: 49' BUILDING WIDTH IN PRIMARY BUILD-TO: 56% (55' / 98') EXISTING BUILDING AREA: 10,837 (3,387 & 7,450 SF; EASTERN BUILDING TO REMAIN VACANT) **EXISTING PARKING REQUIREMENTS:** LIGHT INDUSTRIAL: 1 SPACE PER 3,000 SF @ 10,837 SF INDOOR AREA = 4 SPACES PROPOSED 7,450 SF BUILDING PARKING REQUIREMENTS: LIGHT INDUSTRIAL: 1 SPACE PER 3,000 SF @ 7,450 SF INDOOR AREA = 2 SPACES PROPOSED BAR USE PARKING REQUIREMENTS: 1 SPACE PER EVERY 5 SEATS SF @ 140 SEATS (99 INSIDE, 41 OUTSIDE) = 28 SPACES TOTAL PARKING SPACES REQUIRED: 30 SPACES TOTAL PARKING SPACES PROVIDED: 30 SPACES (2 ADA) SHORT TERM BICYCLE SPACES REQUIRED (1 SPACE PER 50,000 SF GFA, MIN. 4): 4 SPACES SHORT TERM BICYCLE SPACES PROVIDED: 4 SPACES LONG TERM BICYCLE SPACES REQUIRED (1 SPACE PER 25,000 SF GFA, MIN. 4): 4 SPACES LONG TERM BICYCLE SPACES PROVIDED: 4 SPACES BUILDING SETBACKS PRIMARY STREET: 3' SIDE STREET: 3' SIDE LOT LINE: 0' OR 6' REAR LOT LINE: 0' OR 6' PARKING SETBACKS: FROM PRIMARY STREET: 10' FROM SIDE STREET: 10' FROM SIDE LOT LINE: 0' OR 6' FROM REAR LOT LINE: 0' OR 6' REQUIRED AMENITY AREA: 5,407 SF; 0.12 AC (10%) **PROPOSED AMENITY AREA:** 5,560 SF; 0.13 AC (10.3%) DEVELOPER: ISAAC HUNTER'S HOSPITALITY 227 FAYETTEVILLE STREET RALEIGH, NC 27601 919.622.0520 BYANNESSA@GMAIL.COM

When sub	mitting pla	ans, please check th	ie appropria	te buildin	g type and incl	ude the Pla	n Check	list docun	nent.
		BUILDIN	NG TYPE					FOR OFFI	CE USE ONLY
Detached			■ General					Transac	tion Number
☐ Attached			☐ Mixed Us	se				Assigned Pr	oject Coordinator
☐ Apartment☐ Townhouse			☐ Open Lot	:				Assigned	l Team Leader
Has your project previou	sly been thr	ough the Due Diligen		9		provide the	transact	ion # 58(0266
Development Name			GENERAL	INFORIVI	ATION				
Development Name Bo		Overlay Distri	ct (if applicab	le) n/a		Inside City	Limits?	■ _{Yes}	\square_{No}
Proposed Use Bar									
Property Address(es) 10	930 Wa	ke Forest Ro	oad		Major Street	Locator:			
Wake County Property Id				ch these gu	uidelines will app	ly:			
P.I.N. 1714-18-4	795	P.I.N.		P.I.N.			P.I.N.		
What is your project type? Mixed Residential Duplex Other: If other, please d	Non-Res	dential Condo	Elderly Fac		Hospitals Shopping Cent Residential Co	er \square	Hotels/N Banks Retail		Office Industrial Building Cottage Court
WORK SCOPE	occupancy	ode Section 10.2.8.D.: (per Chapter 6 of the of use from light ed to be change	e UDO), indica ht industria	ite impacts al to bai	on parking requarts on parking requarts on the contract of the	irements. are two	buildir	ngs on s	site. One is
DESIGN ADJUSTMENT OR ADMIN ALTERNATE	Administra	ode Chapter 8, summ ative AE adjustment will							
	Compan	BLOOMS, Ir	nc.		Name (s)	Ben Ya	nnes	sa	
CLIENT/DEVELOPER/ OWNER	Address 1930 Wake Forest Road								
	Phone C	19-622-0520	O Email	byann	essa@gm	ail.com	ŀ	ax N/A	\
CONSULTANT	Compan	FLM Engine	eering, Ir	nc.	Name (s)	Chase	Mass	sey, P	<u> </u>
CONSULTANT (Contact Person for	Address	PO Box 917	27, Rale	igh, N	C 27613				
Plans)		919-423-8975			ssey@flmeng			Fax N/A	

Administrative Site Review Application

(for UDO Districts only)

Zoning Information	TABLE (Applicab	Building Information
Zoning District(s) IX-3-PL		roposed building use(s) Bar
If more than one district, provide the acreage of each:		xisting Building(s) sq. ft. gross 10,637
A British A British Company of the C		roposed Building(s) sq. ft. gross (0,037
Overlay District N/A	**************************************	part of a superior and the property of the superior and t
Total Site Acres Inside City Limits Yes No 1.29	AND DESCRIPTION OF THE PERSON	otal sq. ft. gross (existing & proposed) 10,637
Off street parking: Required 30 Provided 30		roposed height of building(s) 22'-2"
COA (Certificate of Appropriateness) case # N/A		of stories 1
BOA (Board of Adjustment) case # A- N/A	······································	eiling height of 1 st Floor 22'-2"
CUD (Conditional Use District) case # Z- N/A		
	ter Information	
Existing Impervious Surface 0.85 / 37,216 acres/square feet	Fi	ood Hazard Area Yes No
Proposed Impervious Surface 0.85 / 37,120 acres/square feet	The Section States Control	Yes, please provide:
Neuse River Buffer ☐ Yes ■ No Wetlands ☐ Yes ■ N	M-11	Iluvial Soils Flood Study EMA Map Panel #
FOR RESIDENT	IAL DEVELOPME	
Total # Of Apartment, Condominium or Residential Units	5. Bedroom U	Inits: 1br 2br 3br 4br or more
2. Total # Of Congregate Care Or Life Care Dwelling Units	6. Infill Develo	opment 2.2.7
3. Total Number of Hotel Units	7. Open Space	e (only) or Amenity
4. Overall Total # Of Dwelling Units (1-6 Above)	f Dwelling Units (1-6 Above) 8. Is your project a cottage court? Yes No	
SIGNATURE BLOCK (App	plicable to all de	velopments)
In filing this plan as the property owner(s), I/we do hereby agree and f and assigns jointly and severally to construct all improvements and ma approved by the City. I hereby designate Chase Massey receive and respond to administrative comments, to resubmit plans or application.	ake all dedications	as shown on this proposed development plan as
I/we have read, acknowledge and affirm that this project is conforming use. Signed		Date 6/25/2019
DATE TO THE PARTY A STORY OF THE PARTY OF TH		
Signed	······································	Date
Printed Name		Andrew Control of the
	LEIGHNC.G	OV REVISION 05.13.



POST OFFICE BOX 91727 RALEIGH. NORTH CAROLINA 27675 PHONE: 919.610.1051 FIRM NC LICENSE NUMBER C-4222

REVISION HISTORY

REV # DESCRIPTION DATE BY 1 ASR COMMENTS 6/25/2019 FLM 2 ASR COMMENTS 8/19/2019 FLM				
	1	DESCRIPTION	DATE	BY
2 ASR COMMENTS 8/19/2019 FLM	1	ASR COMMENTS	6/25/2019	FLM
	2	ASR COMMENTS	8/19/2019	FLM

ORIGINAL PLAN SIZE: 24" X 36"

PRELIMINARY **PLANS** DO NOT USE FOR CONSTRUCTION

ENGINEER OF RECORD:

NOTES

SHEET

C-2

C-3

C-4

C-5

A-1.0

1. THE SITE (1.29 AC) IS EXEMPT FROM TREE CONSERVATION AREAS (TCAs) PER CITY OF RALEIGH UNIFIED DEVELOPMENT ORDINANCE (UDO) SECTION

SECTION 9.2.2.A.3.b OF THE UDO. THERE IS NO INCREASE IN IMPERVIOUS

3. SOLID WASTE INSPECTIONS STATEMENT: THE DEVELOPER HAS REVIEWED

AND IS IN COMPLIANCE WITH THE REQUIREMENTS SET FORTH IN THE SOLID WASTE DESIGN MANUAL. CITY OF RALEIGH SOLID WASTE SERVICES

(SWS) IS INTENDED TO HANDLE TRASH NEEDS THROUGH USE OF

ON JULY 8, 2019 PER CASE NUMBER A-94-19.

TITLE

COVER

EXISTING CONDITIONS

EXISTING ELEVATIONS

GRADING & DRAINAGE PLAN

SITE & UTILITY PLAN

LANDSCAPE PLAN

BLOCK PERIMETER (UDO 8.3.2.A) & CROSS ACCESS REQUIREMENTS

CROSS-ACCESS (UDO 8.3.5.D) DESIGN ADJUSTMENTS APPROVED BY BOA

2. THIS SITE IS EXEMPT FROM STORMWATER RUNOFF CONTROLS PER

FLM ENGINEERING, INC CONTACT: CHASE MASSEY, PE PO BOX 91727 RALEIGH, NC 27675 919.423.8975 CMASSEY@FLMENGINEERING.COM

DEVELOPER:

ISAAC HUNTER'S HOSPITALITY CONTACT: BEN YANNESSA 227 FAYETTEVILLE STREET RALEIGH, NC 27601 919.622.0520 BYANNESSA@GMAIL.COM

NORTH CAROLINA **ONE-CALL CENTER**

1-800-632-4949

SCALE AD.	JUSTMENT
THIS BAR IS 1 IN ON ORIGINA	
0	1"
IF IT IS NOT 1	INCH ON THIS

SHEET, ADJUST YOUR SCALE

ACCORDINGLY

ADMINISTRATIVE SITE PLANS TRANS. # 589608 ASR-SR-22-2019

BOWSTRING BAR 1930 WAKE FOREST ROAD RALEIGH, NC 27608

DATE:	03-14-2019
SCALE:	AS SHOWN
DESIGNED BY:	TCM
APPROVED BY:	FLM
PROJECT NO.:	19003

COVER

SHEET 1 OF 6

CALL 48 HOURS BEFORE

CALL 48 HOURS BEFORE


YOU DIG

North!

ENGINEER:

PO BOX 91727 RALEIGH, NC 27675 919.423.8975

FLM ENGINEERING, INC.

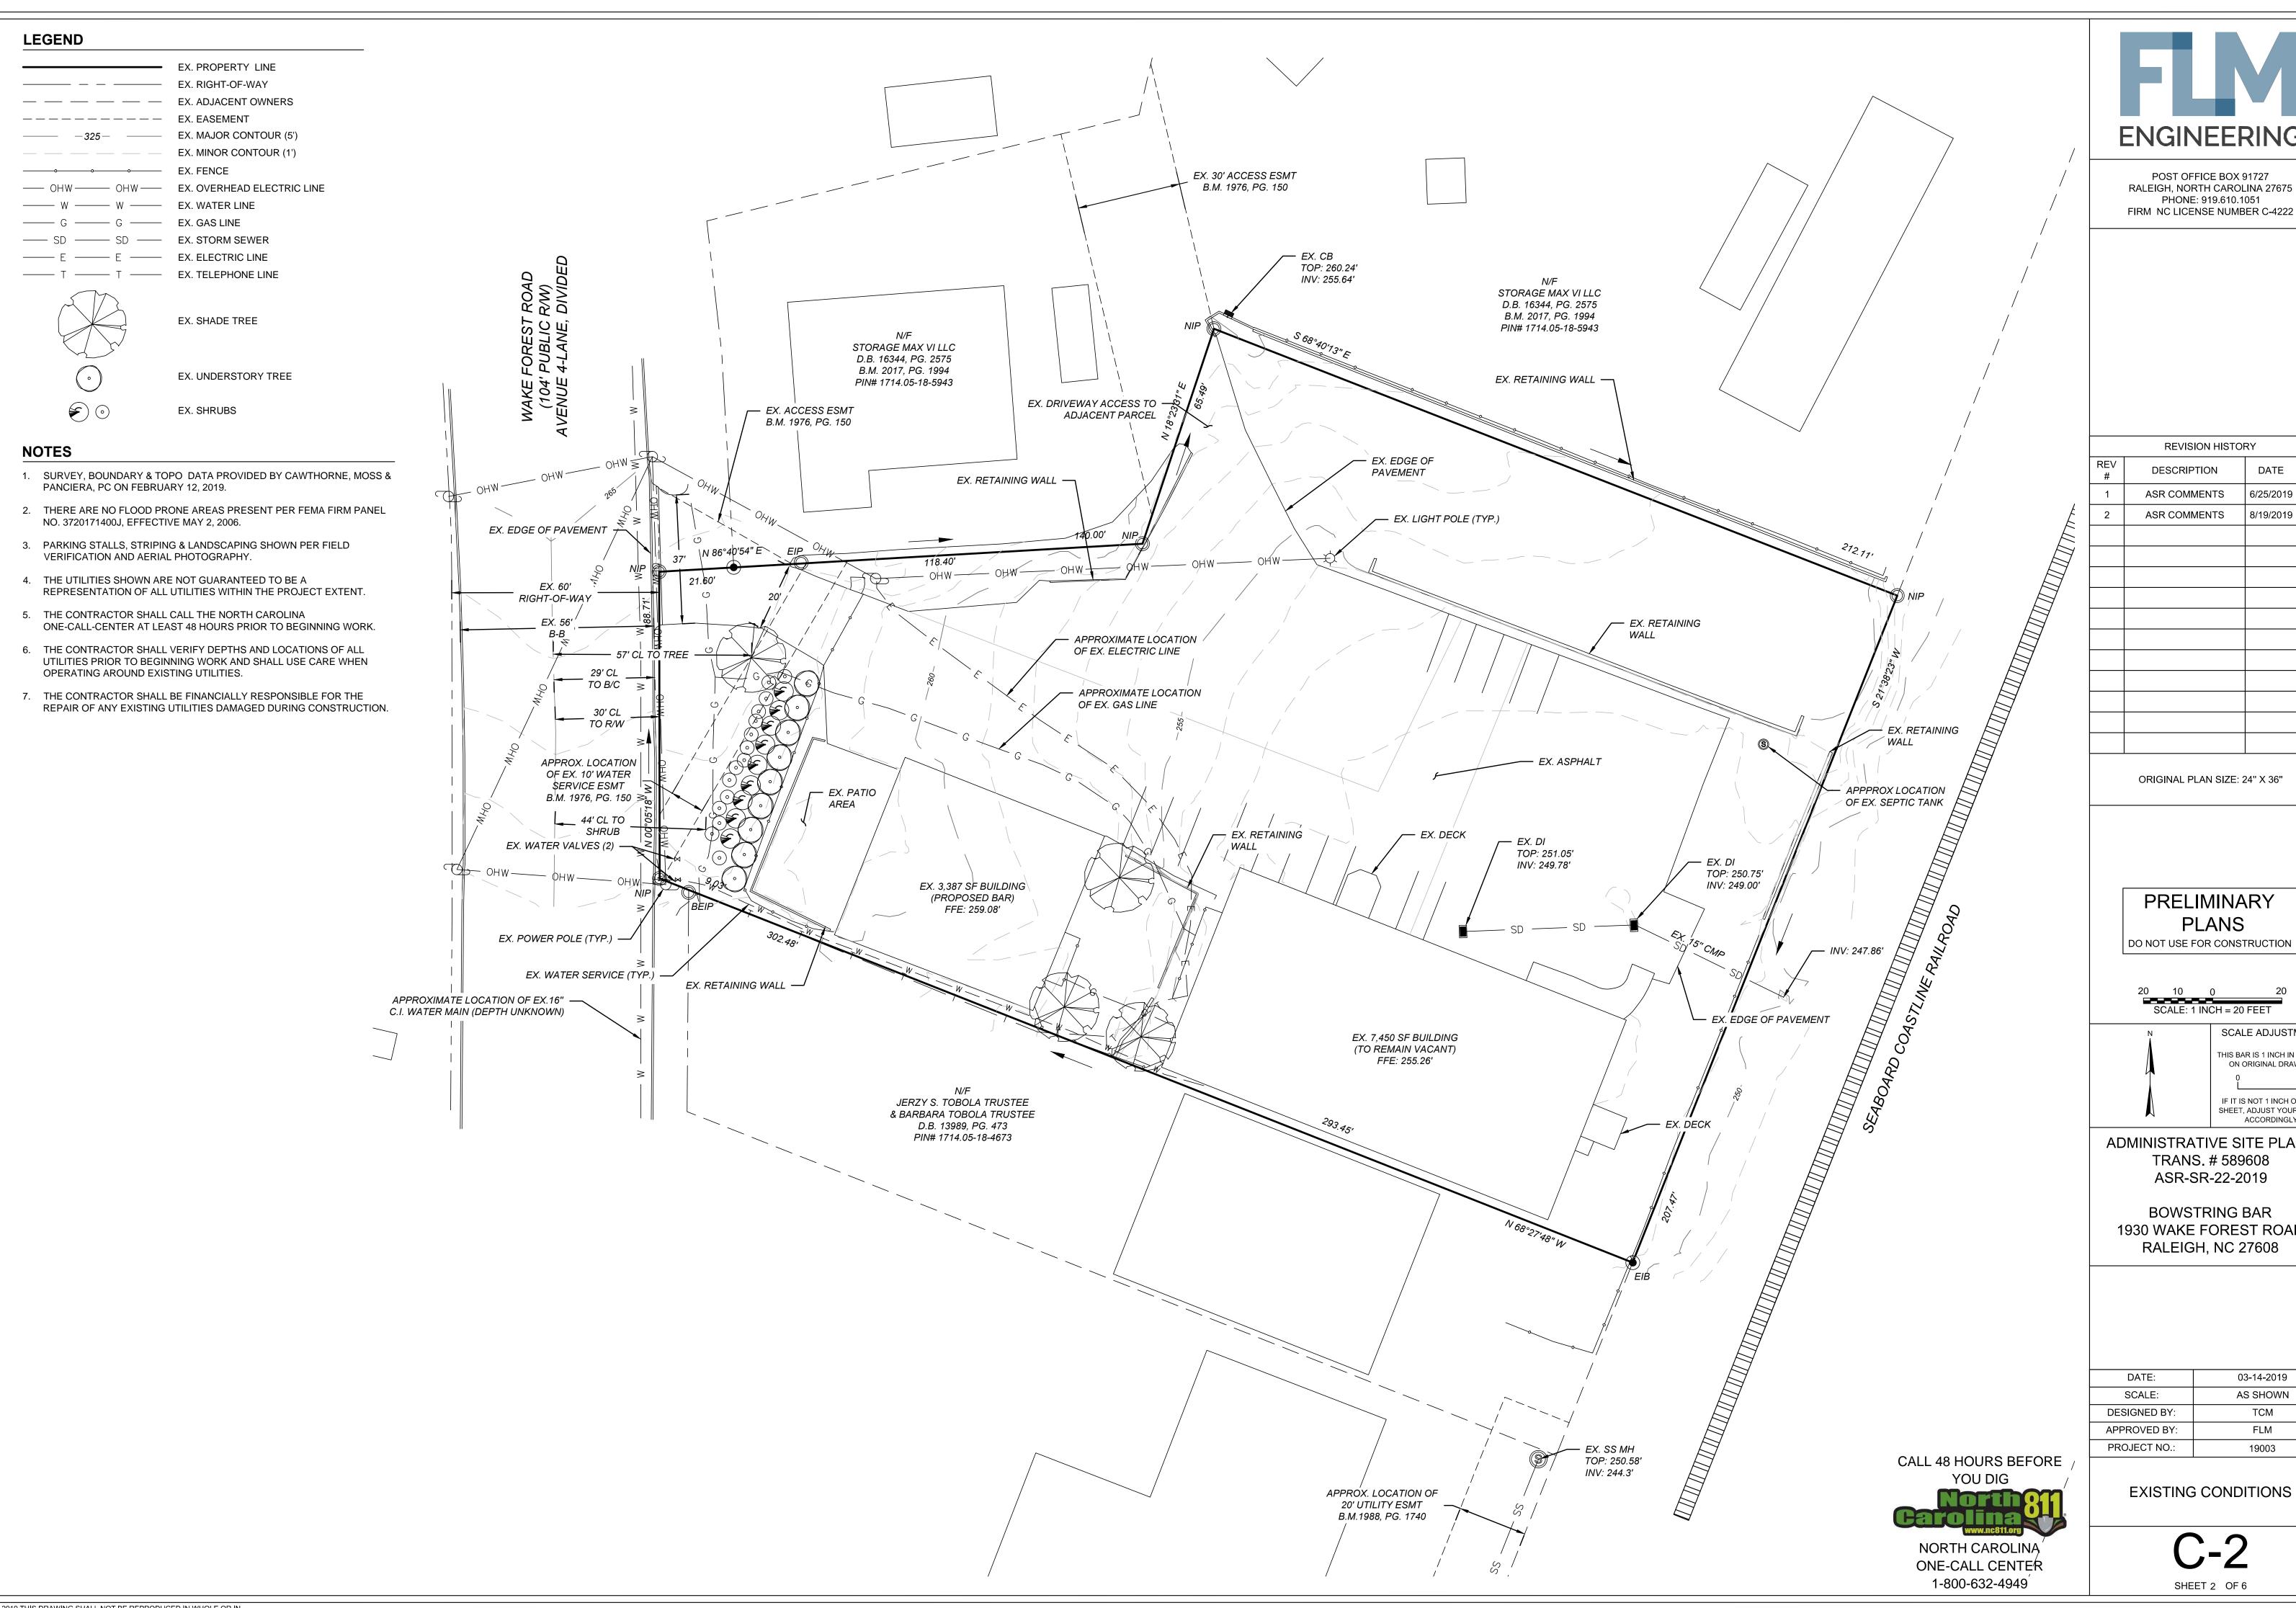

ENGINEERING


POST OFFICE BOX 91727 RALEIGH, NORTH CAROLINA 27675 PHONE: 919.610.1051 FIRM NC LICENSE NUMBER C-4222

REVISION HISTORY

REV #	DESCRIPTION	DATE	BY
1	ASR COMMENTS	6/25/2019	FLM
2	ASR COMMENTS	8/19/2019	FLM

ORIGINAL PLAN SIZE: 24" X 36"

PRELIMINARY **PLANS**

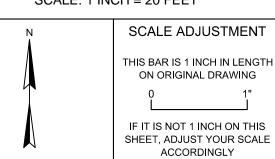


ADMINISTRATIVE SITE PLANS TRANS. # 589608 ASR-SR-22-2019

BOWSTRING BAR 1930 WAKE FOREST ROAD RALEIGH, NC 27608

DATE:	03-14-2019
SCALE:	AS SHOWN
DESIGNED BY:	TCM
APPROVED BY:	FLM
PROJECT NO.:	19003

EXISTING CONDITIONS

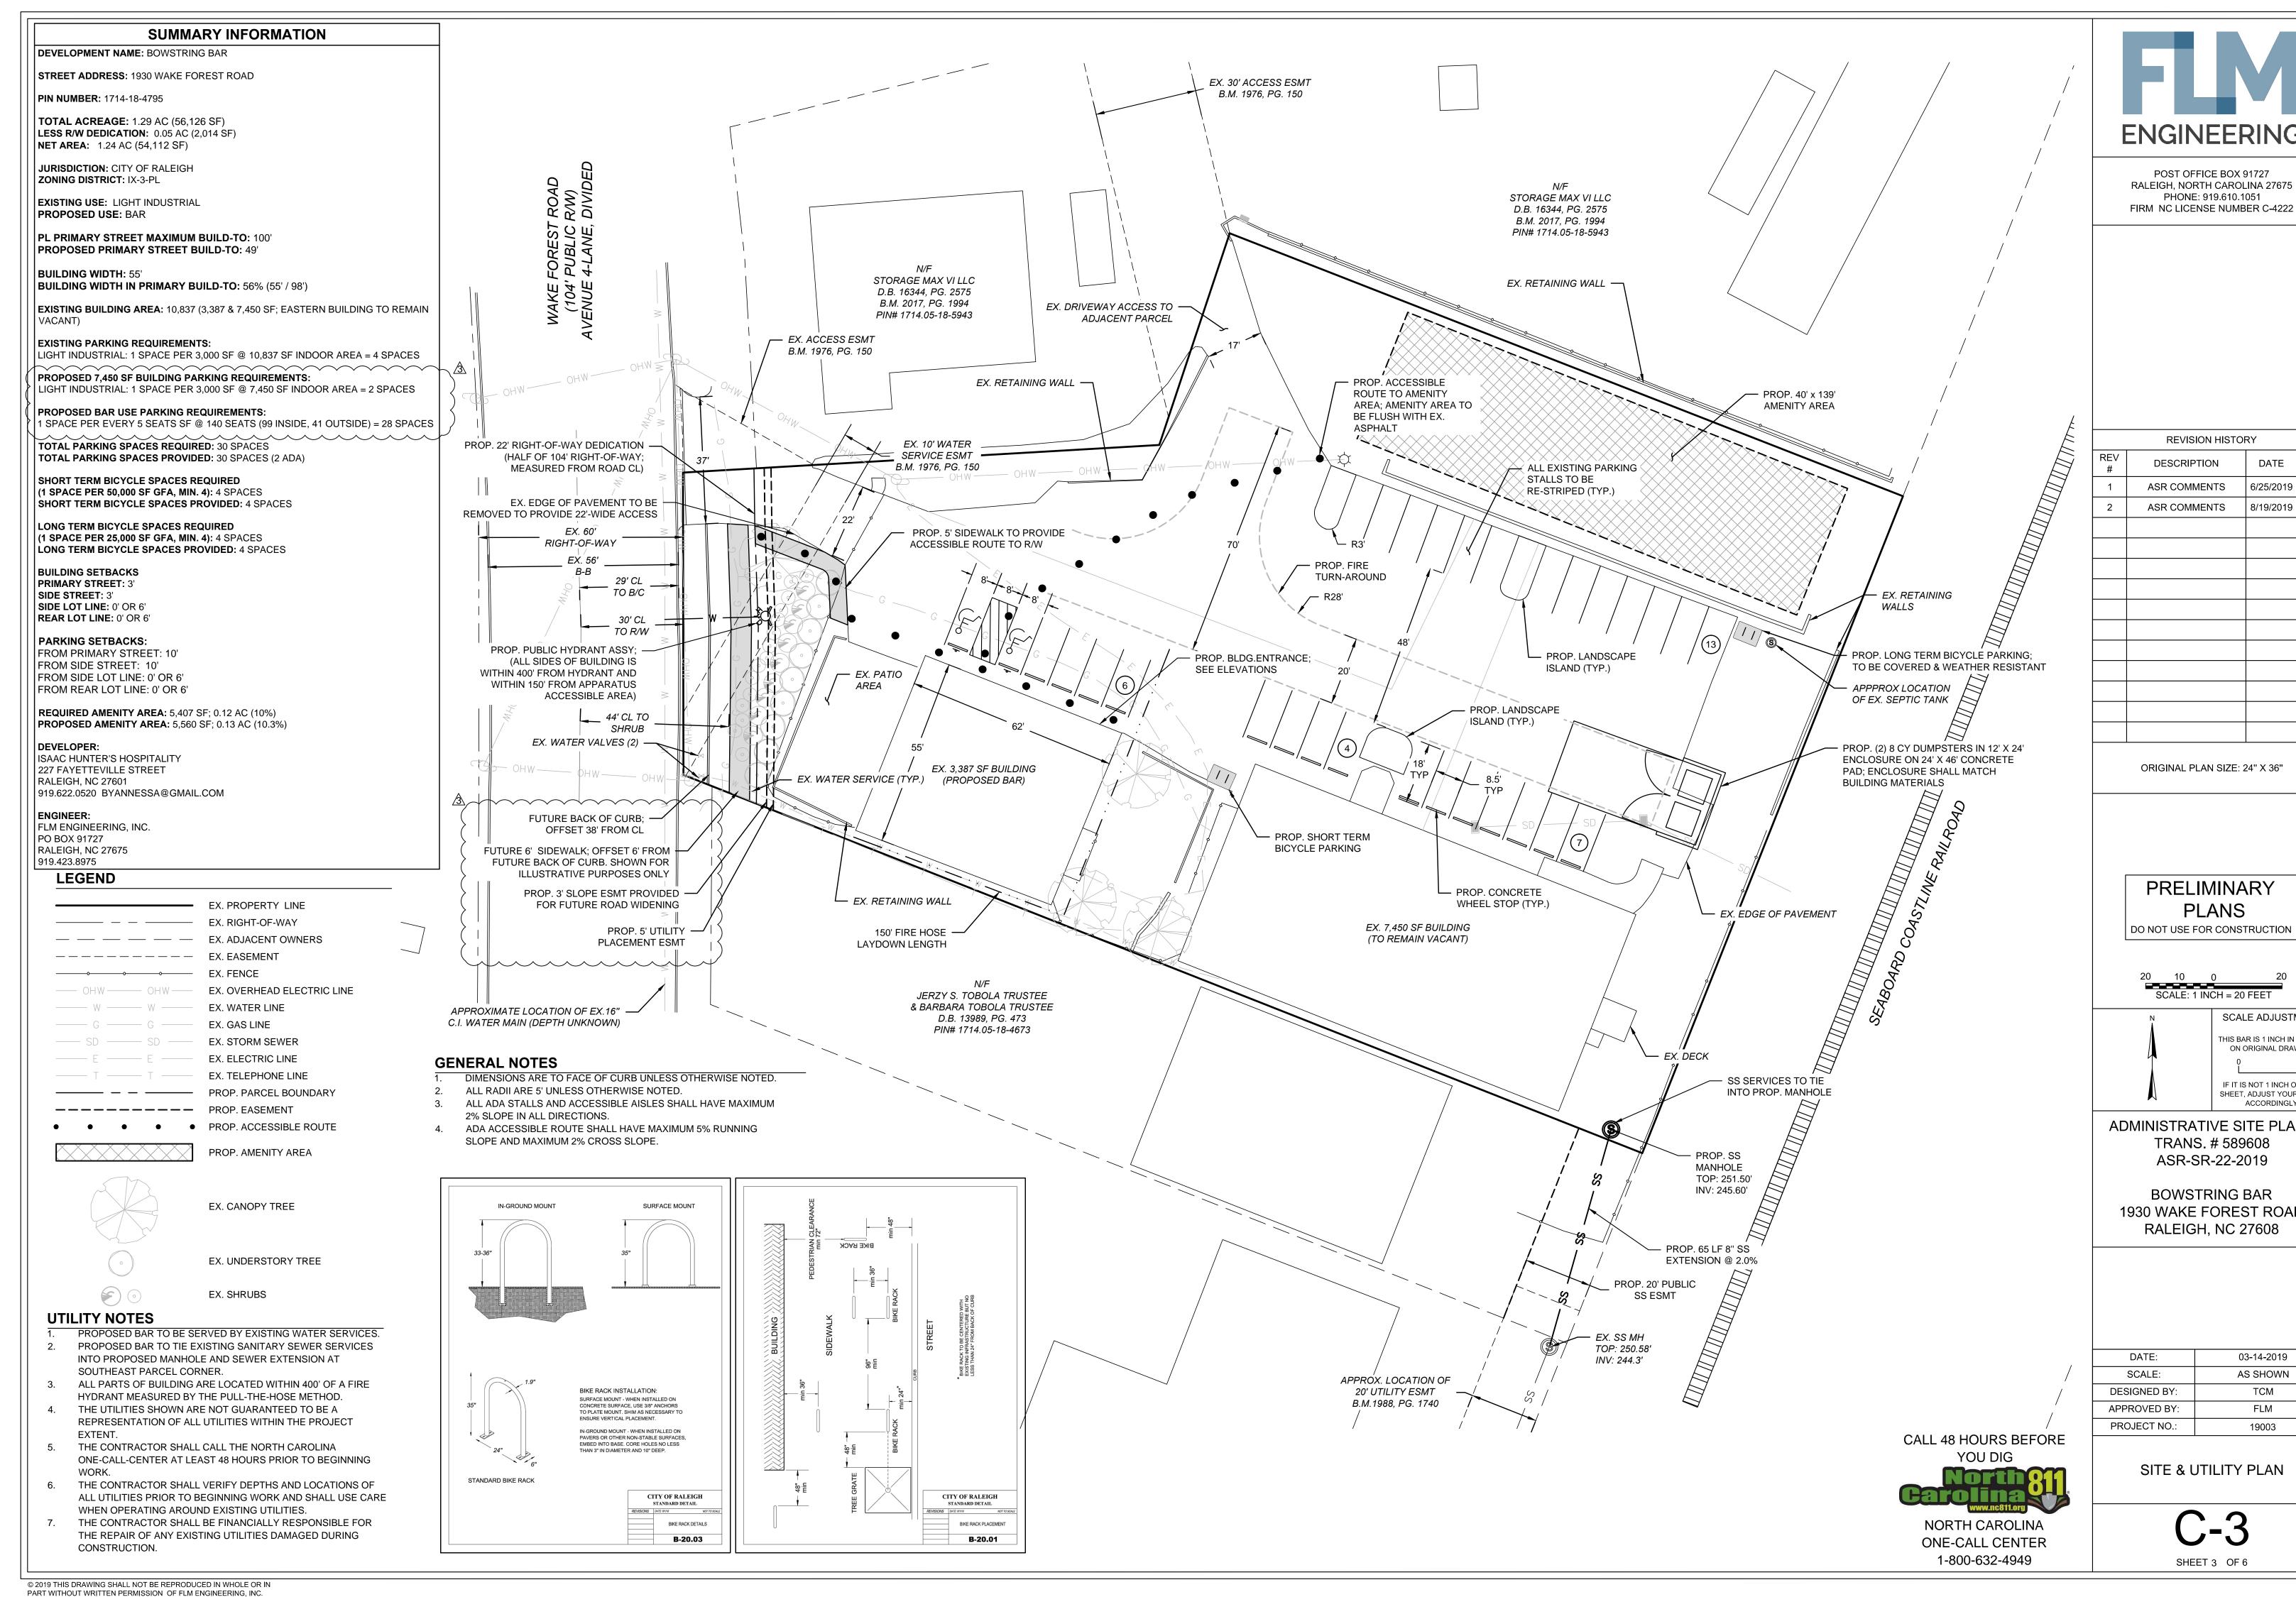

ENGINEERING

RALEIGH, NORTH CAROLINA 27675 FIRM NC LICENSE NUMBER C-4222


REV #	DESCRIPTION	DATE	ВУ
1	ASR COMMENTS	6/25/2019	FLI
2	ASR COMMENTS	8/19/2019	FLI
			·

SCALE ADJUSTMENT THIS BAR IS 1 INCH IN LENGTH ON ORIGINAL DRAWING IF IT IS NOT 1 INCH ON THIS SHEET, ADJUST YOUR SCALE ACCORDINGLY

ADMINISTRATIVE SITE PLANS


1930 WAKE FOREST ROAD

DATE:	03-14-2019
SCALE:	AS SHOWN
DESIGNED BY:	TCM
APPROVED BY:	FLM
PROJECT NO.:	19003

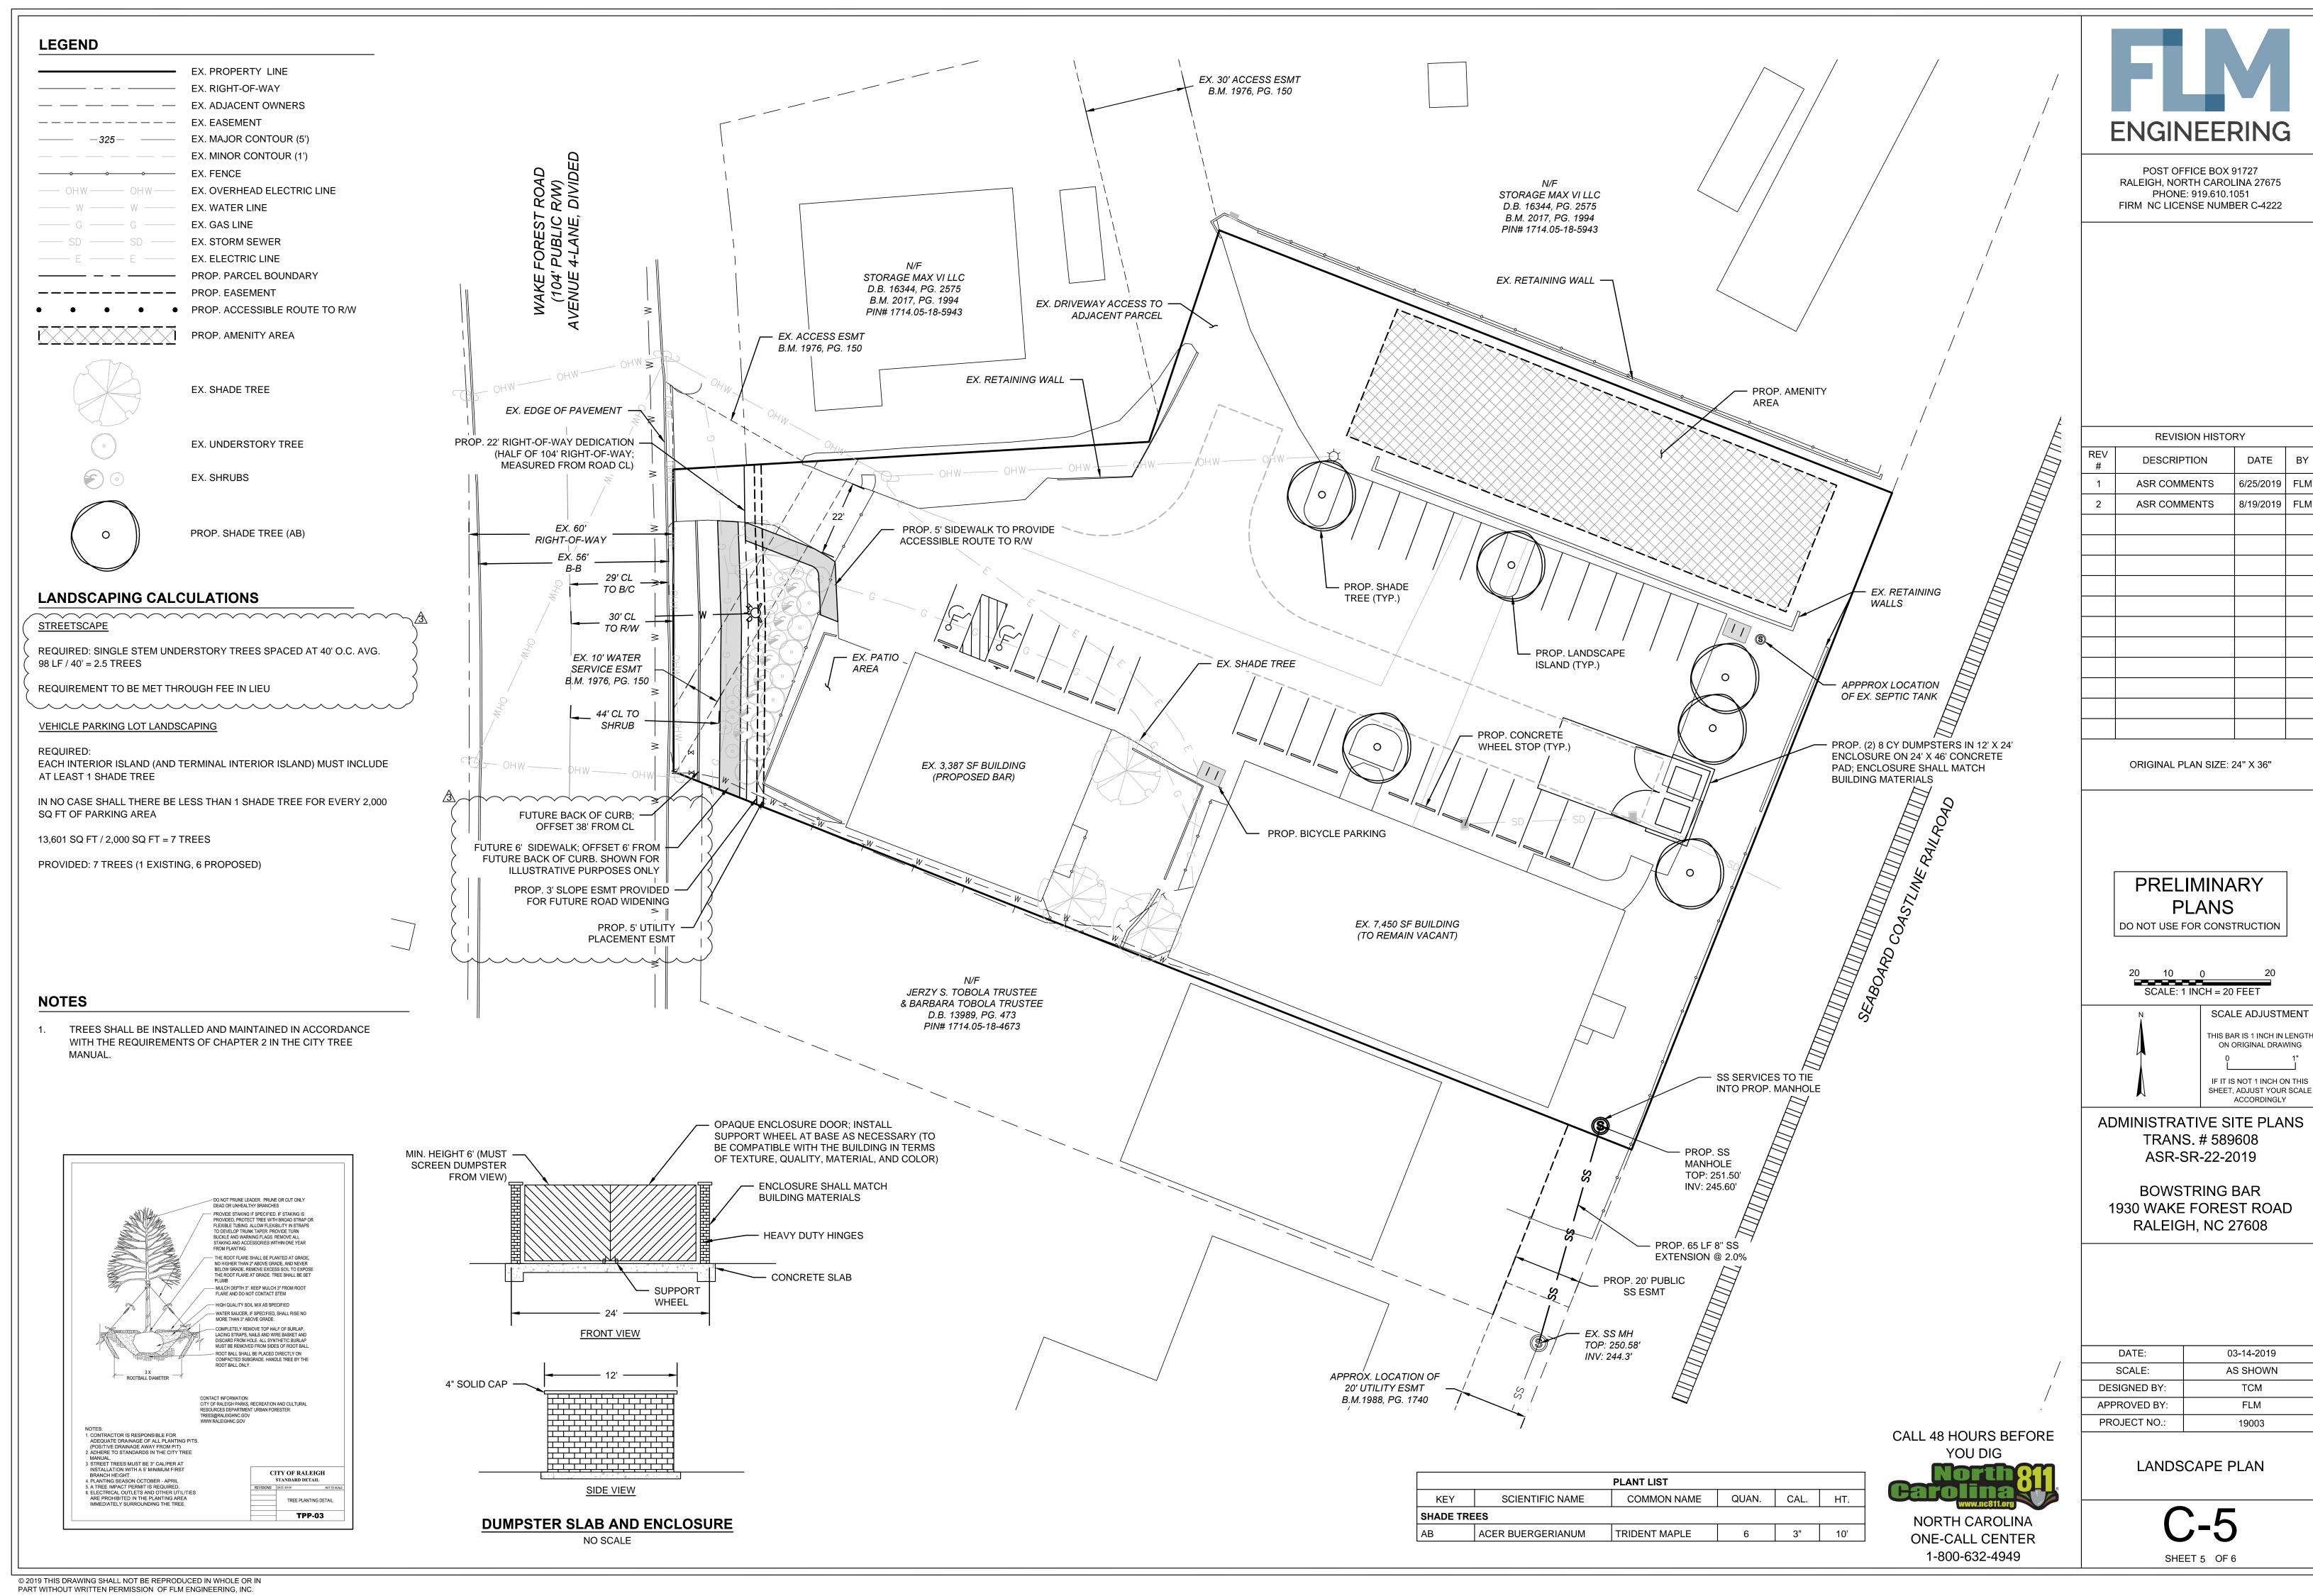

DESCRIPTION	DATE	BY
ASR COMMENTS	6/25/2019	FLM
ASR COMMENTS	8/19/2019	FLM
	ASR COMMENTS	ASR COMMENTS 6/25/2019

DATE:	03-14-2019
SCALE:	AS SHOWN
DESIGNED BY:	TCM
APPROVED BY:	FLM
PROJECT NO.:	19003

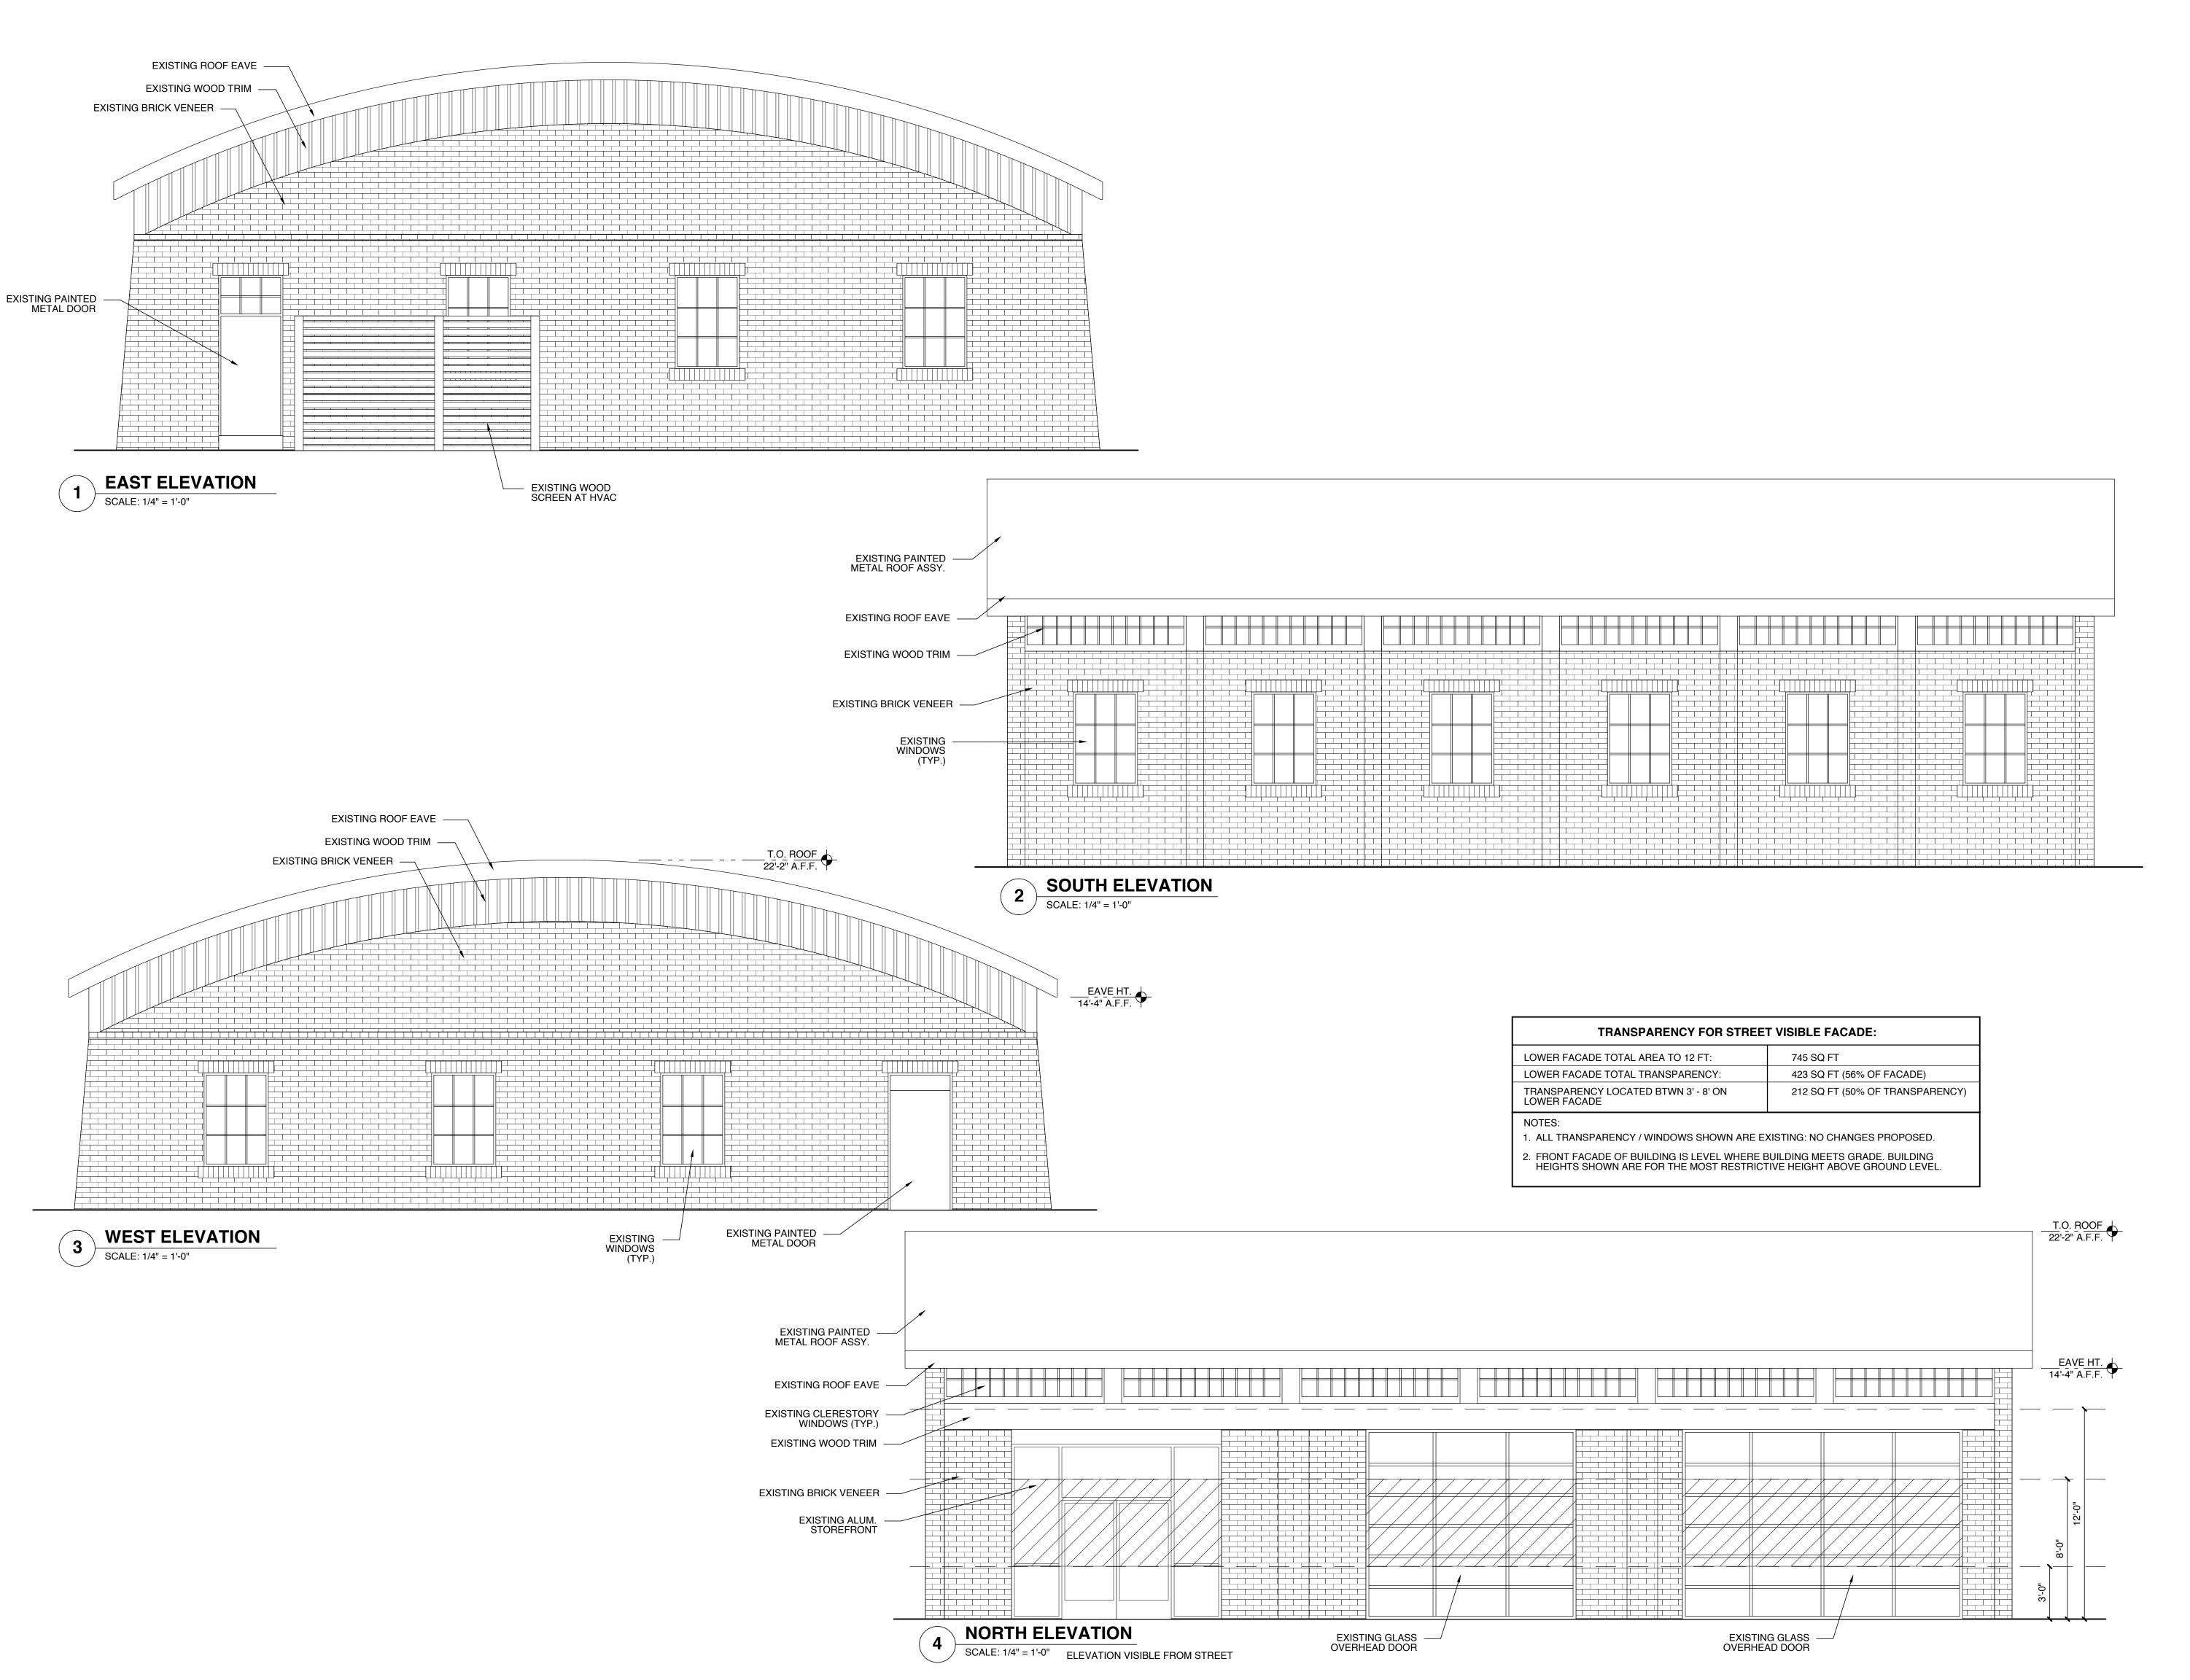

WEEKS TURNER ARCHITECTURE

WEEKS TURNER ARCHITECTURE, PA 3305-109 Durham Drive Raleigh, North Carolina 27603 919.779.9797 fax: 919.779.0826 www.weeksturner.com

AINO ISNINISIEN WOL

PROJECT TITLE

BOWSTRING BAR
RENOVATIONS

1930 WAKE FOREST RD.
RALEIGH, NORTH CAROLINA

PROJECT NO.

1913

DRAWING TITLE

DRAWING TITLE

EXISTING

ELEVATIONS

SHEET 1 OF

A1.0

PLOT DATE REVISION

2/28/19 00/00/17

This original sheet is 24" x 36"; other dimensions indicate it has been altered.

All information on this sheet is the property of Weeks Turner Architecture and may not be duplicated in whole or in part without written authorization from Weeks Turner Architecture. 2017 ©