

410 Glenwood Ave

Address

**Historic District** 

(former) Pine State Creamery
Historic Property

COA-0148-2025

Certificate Number

12/3/2025

Date of Issue

6/3/2026

**Expiration Date** 

# CERTIFICATE OF APPROPRIATENESS PLACARD

for Raleigh Historic Resources

#### **Project Description:**

Alteration to previously approved COA: including south elevation and galleria storefront / service door rearrangements; parking garage screen material revisions; changing precast to metal panel for industrial grid cladding; changing metal mesh to corrugated perforated material; altering the galleria ceiling profile and material; loggia revisions including brick selection and louver location

This card must be kept posted in a location within public view until all phases of the described project are complete. The work must conform with the code of the City of Raleigh and laws of the state of North Carolina. When your project is complete, you are required to ask for a final zoning inspection in a historic district area. Telephone the RHDC office at 832-7238 and commission staff will coordinate the inspection with the inspections Department. If you do not call for this final inspection, your Certificate of Appropriateness is null and void.

Signature,

Raleigh Historic Development Commission

Pending the resolution of appeals, commencement of work is at your own risk.

Type or print the following:									
Applicant name:									
Mailing address:									
City:	State:		Zip code:						
Date:	I	Daytime phone :	#:						
Email address:									
Applicant signature:	$\rightarrow$								
Minor work (staff review) –	one copy		Office Use Only						
Major work (COA committe	e review) – ten	Transaction	#:						
copies		File #: CO	A-0148-2025						
Additions > 25% of b	ouilding sq. footage	Fee:							
New buildings		Amount paid	d:						
Demolition of buildin	g or structure	Received da	ate:						
All other		Received by	<b>y</b> :						
Post approval re-review of	conditions of								
approval									
Property street address:									
Historic district:									
Historic property/Landmark name	(if applicable):								
Owner name:									
Owner mailing address:									
For applications that require revand stamped envelopes for own as well as the property owner.	_	` -	• •						
Property Owner Name & A	Address	Property	y Owner Name & Address						

Page 1 of 2 REVISION 7.2.19

I understand that all major work applications that require review by the Raleigh Historic Development Commission's COA Committee must be submitted by 4 p.m. on the date of the application deadline; otherwise, consideration will be delayed until the following committee meeting. An incomplete application will not be accepted.

Will you be applying for rehabilitation tax credits for this project?

Yes No Did you consult Yes No	with staff prior to	o filing the application?	Type of work: 71, 89
Design	Guidelines: please	cite the applicable sections of the	design guidelines (www.rhdc.org).
Section/Page	Topic	Brief description of work	(attach additional sheets as needed).
		See	e attached
ne diak pen			
Please post the en Certificate shall no City Code or any la	closed placard form t relieve the applica	of the certificate as indicated at the b nt, contractor, tenant, or property own e subject to an appeals period of 30 da	his application becomes the Minor Work  pottom of the card. Issuance of a Minor Work her from obtaining any other permit required by

Office Use Only

#### **Pine State Creamery**

Material and Detail Modifications to Previously-Approved COA

#### Summary of Historical Significance:

- 1. The Raleigh Historic Landmark Application identifies the 1928 original building as the historically-significant component of the Pine State Creamery complex.
- 2. The National Register Nomination is the Raleigh Historic Landmark Designation Report:
  - The NR Nomination establishes the period of significance for the property as 1928-1947.
  - The NR Nomination relates the architectural significance of Pine State Creamery to its prominence in the streetscape, particularly at the Glenwood/Tucker intersection:
    - "Both the five-bay north façade and the six-bay west façade along Glenwood Avenue are of equal importance, united by a three-story tower at the corner."
    - "The Pine State Creamery is an imposing and well-preserved Art Moderne industrial plant, a landmark of the era when industrial buildings had an architectural presence on urban thoroughfares."

      The nomination highlights the crenellated parapet and tower as the primary architectural feature: "The chief architectural interest of the building is concentrated at the roofline, where a crenellated parapet with concrete coping extends above the flat, built-up roof. Pilasters extend through the second story to the parapet, terminating in concrete cartouches of Moderne design. At the street corner, a third story tower steps back from the wall plane, with corner buttresses with similar cartouches and a crenellated roof line with blind bull's eye brickwork designs in each of the two tower faces."
  - The NR Nomination describes the remainder of the complex as:

    "The additions are unobtrusive, leaving the original building as the most prominent feature of the streetscape."

#### Summary of Phased Development:

There are two separate phases of work included within the previously-approved COAs:

- 1. Phase 1 will include a residential tower to the south of the historic Creamery that is not included within the RHL boundary. A loggia attached to the north side of this residential tower and a portion of the parking deck located on the east side of the residential tower are included within the RHL boundary. Additionally, an outdoor courtyard located between the south wall of the historic Creamery and the new residential tower is also included within the RHL boundary.
- 2. A future Phase 2 will include a second tower and the outdoor spaces to the east of the historic Creamery.

This Minor COA Application addresses miscellaneous alterations to the materials and details for the parking garage elevations and the street level storefronts at the base of the parking garage, galleria, and loggia:

- 1. Street level storefront / service door rearrangements at South Elevation (North St)
- 2. Material revisions at parking garage screen South Elevation (North St) + East Elevation (RR):
  - Metal panel in lieu of precast for the cladding of the industrial grid (parking garage levels only)
  - Corrugated perforated material in lieu of expanded metal mesh for the parking garage screening
- 3. Street level storefront rearrangements at the galleria
- 4. Galleria ceiling revisions:
  - Flat in lieu of shaped profile
  - Synthetic stucco in lieu of precast concrete for the ceiling finish
- 5. Material revisions at the loggia (north side of residential building):
  - Buff colored brick in lieu of glazed blue brick and steel railing at the roof fascia
  - Louver band shifted from building wall to loggia fascia

It is understood that all other conditions of approval as outlined in the December 09, 2021 Decision Letter remain in effect.

#### Material/Detail Modifications at South Elevation (North St) + East Elevation (RR)

#### Summary of street level storefront / service door rearrangements at South Elevation (North St):

- 1. The previously-approved elevation included a vehicular garage entry in the east bay, utility/equipment room in the center bay, and a commercial storefront in the west bay. Based on the final engineering for the project, the center and west bays are both required to accommodate equipment and will require overhead door access.
  - The brick and concrete frame and the three associated storefront bay sizes remain consistent with the previously-approved COA.
  - The storefront elevation for these two bays has been revised to include a mix of overhead doors and storefronts in both bays to provide required service access while maintaining an equivalent amount of glazing as shown in the previously-approved COA.

#### Summary of material revisions at parking garage screen – South Elevation (North St) + East Elevation (RR):

- 1. The industrial grid has been revised from precast concrete to painted metal panel. As shown in the comparative elevations for the previously-approved and currently proposed elevations, the overall massing, dimensions, and color range of the industrial grid will be generally consistent with the previously-approved COA:
  - The rectangular profiles and widths of the grids (3'-0" for primary and 1'-6" for secondary) match the previously-approved design.
  - Due to manufacturing limitations, the proposed depth of the frame decreases from 12" to 10".
  - The 3" diameter tie rod is visually consistent with the previously-approved COA.
- 2. The mesh screening has been revised from expanded metal to perforated corrugated metal:
  - The level of transparency is generally consistent with the previously-approved COA.
  - The color is consistent with the previously-approved COA.

#### Documentary materials and samples:

- 1. Side-by-side rendered elevations for the previously-approved and currently proposed elevations + enlarged elevations illustrate these modifications. *Note that the proposed elevations represent the reduction in height as approved per COA-0018-2025.*
- 2. Side-by-side photos of the previously-approved renderings and local installations of the proposed mesh illustrate comparative day and night conditions.
- 3. Architectural drawing 1/A3.91 illustrates the street level storefront at the South Elevation (North St). Architectural drawings 2, 3, 4, and 5/A8.51 illustrate the wall sections through the storefront and overhead doors + door schedule A11.02 confirms door sizes per Condition #4 of the December 09, 2021 Decision Letter.
- 4. Architectural drawing A3.90 illustrates a typical parking garage screen bay at the South Elevation (North St) + East Elevation (RR). Shop drawing sheets G100, 1.00, 1.01, and 1.02 illustrate the details for the parking garage grid, mesh, and tie rod.
- 5. A graphic material key shows material colors and selections for the building. *Material samples and colors will be delivered to the RHDC office.*

#### Comparative Views of Parking Garage Mesh





Daytime view of previously-approved rendering (left) and proposed mesh installed at Peace St / West St




Nighttime view of previously-approved rendering (left) and proposed mesh installed at Peace St / West St


## South Elevation (North St.)

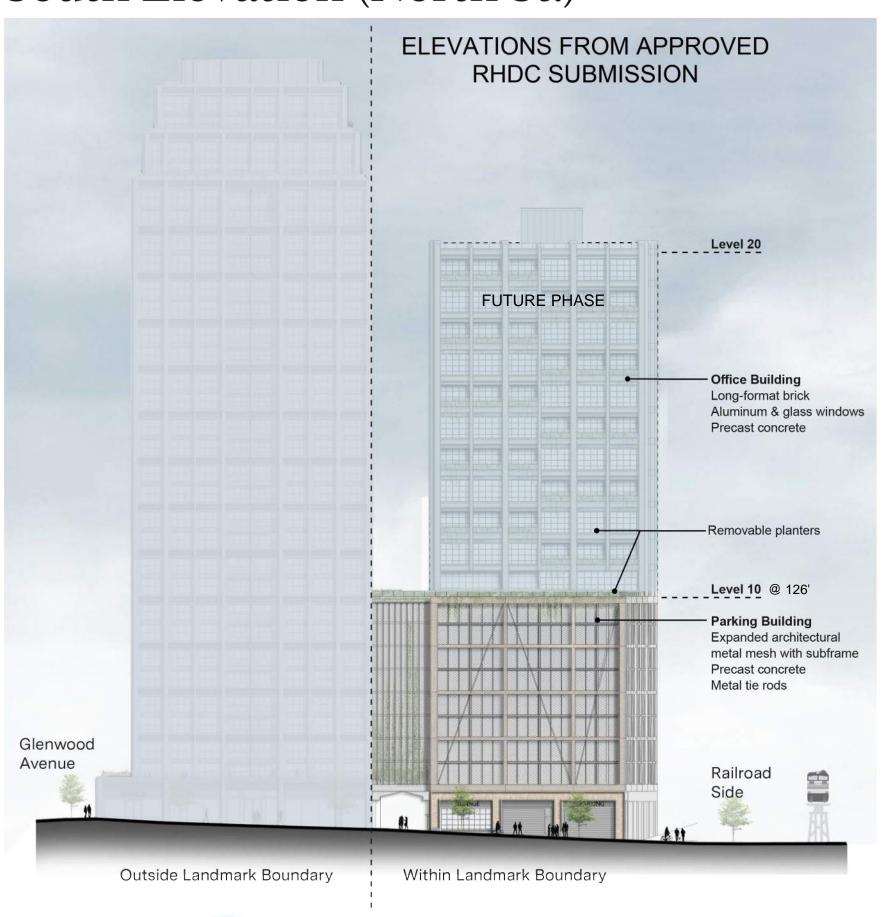

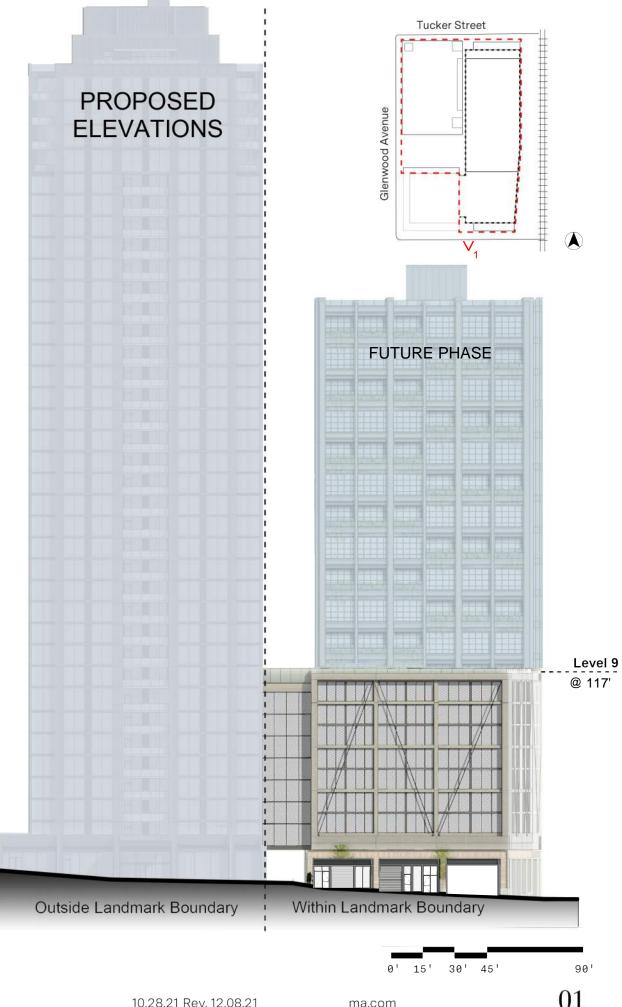


## East Elevation

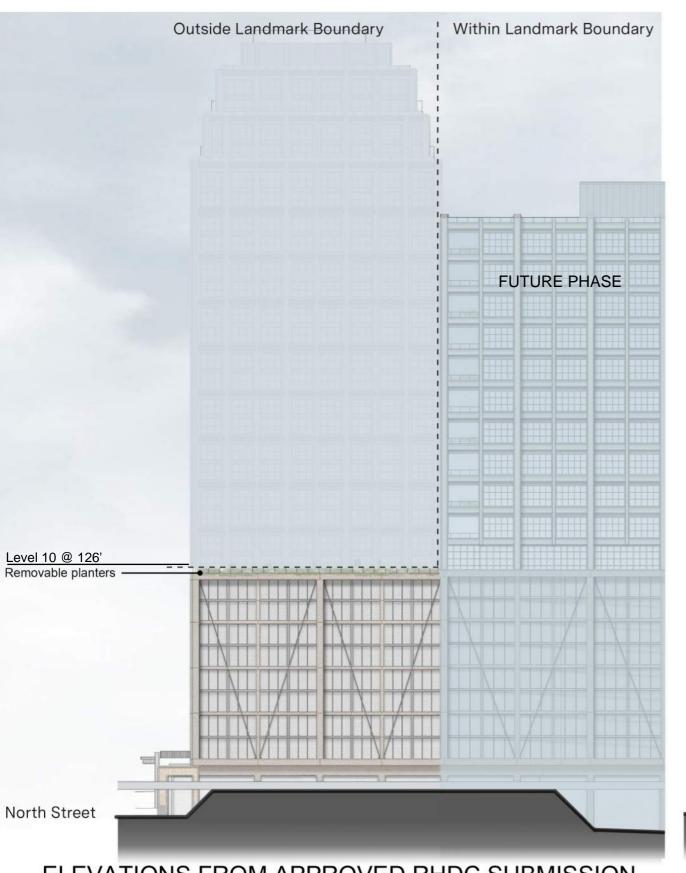

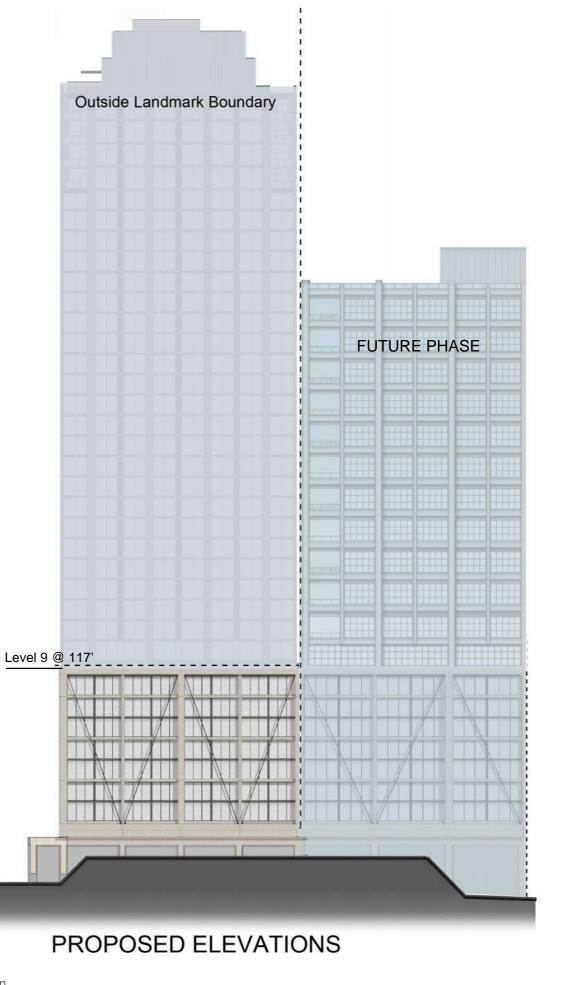

10.28.21 Rev. 12.08.21

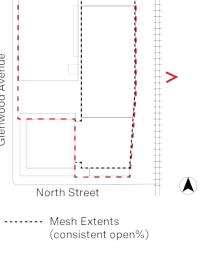

Tucker Street




ma.com


Morris Adjmi Architects


## South Elevation (North St.)



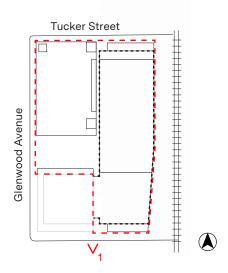


# South Elevation (North St.)

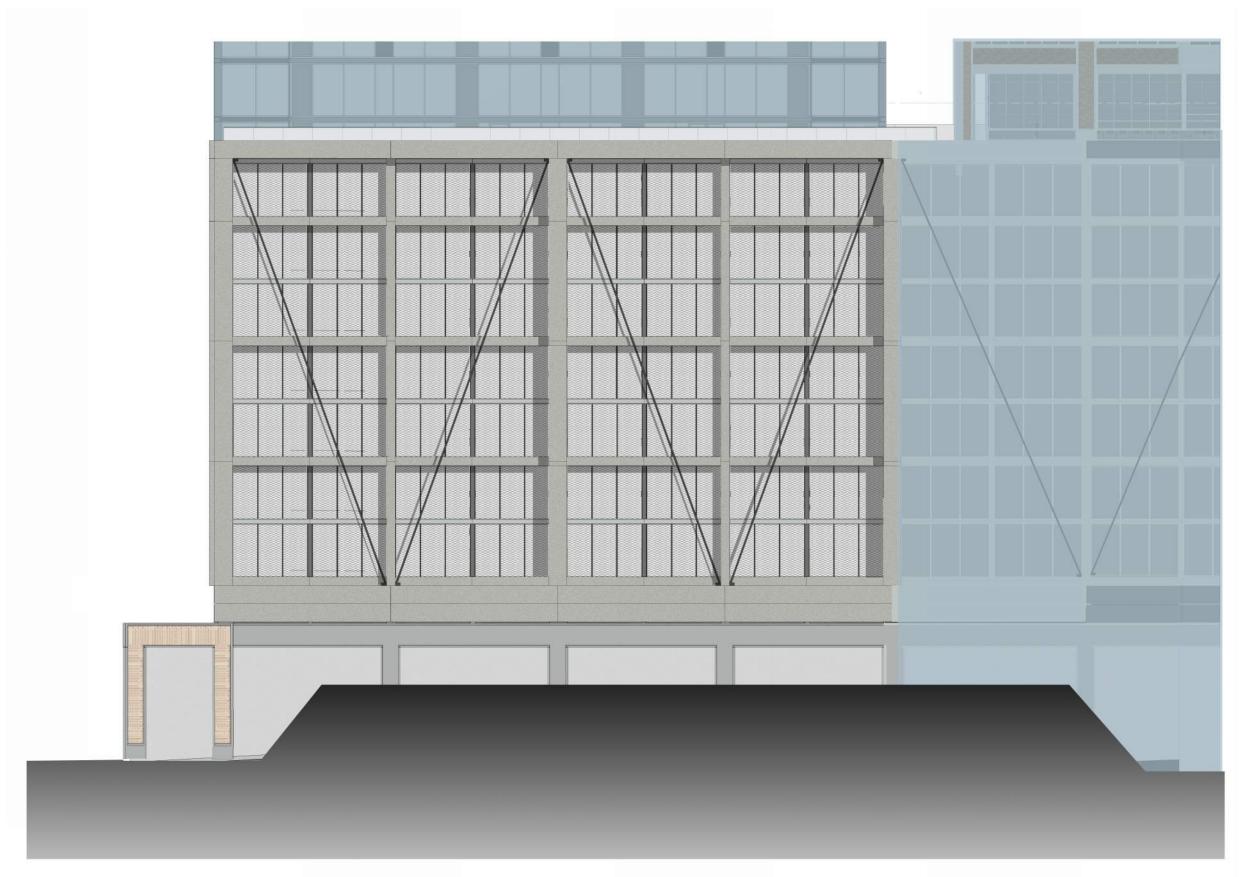


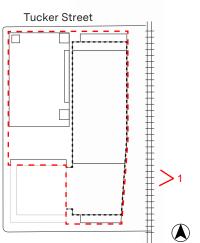


# Parking Screen

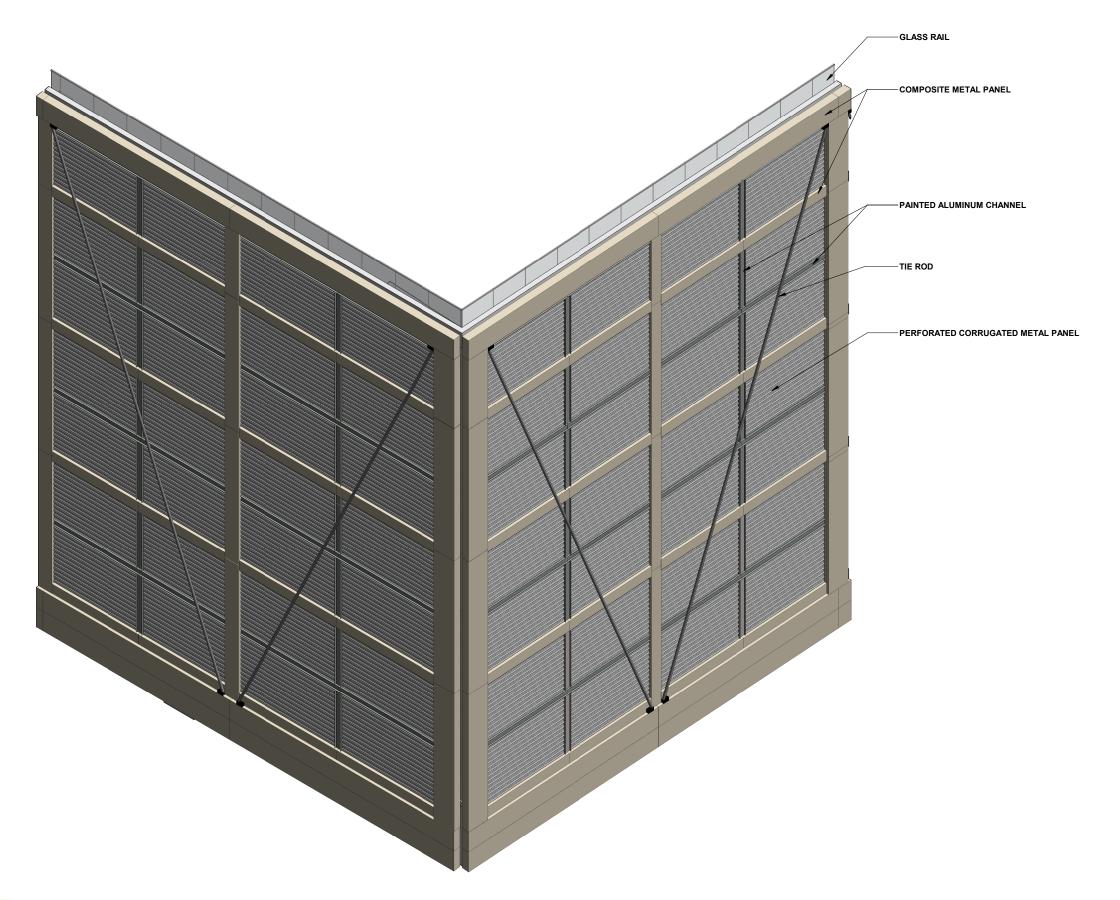

ma.com

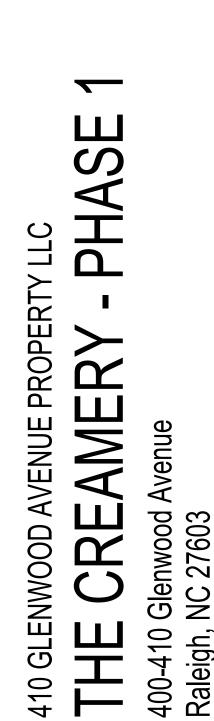

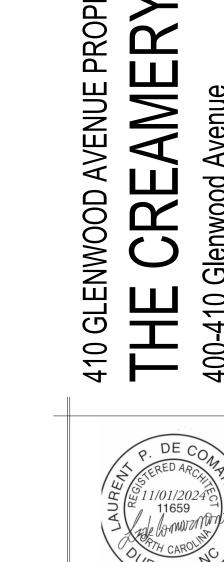

GLASS WIND WALL. STAINLESS STEEL STANCHIONS POST INSTALLED INTO TOPPING SLAB

STAINLESS STEEL COUNTER FLASHING


COLD FLUID APPLIED WATERPROOFING

WITH PROTECTION LAYER

COOL DECK COATING

TOPPING SLAB



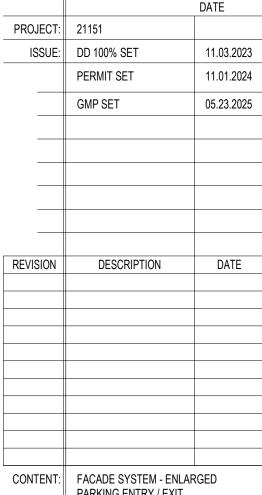

CONTENT: FACADE SYSTEM - ENLARGED PARKING ENTRY / EXIT

A3.91

ROOF EDGE AT AMENITY DECK 3 ROOF DETAIL AT GARAGE 4

PREFINISHED METAL COPING

THRU WALL SCUPPER - REFER TO PLAN


COMPOSITE ALUMINUM PANEL


ALUMINUM CHANNEL -

ALUMINUM TUBE FRAMING

PERFORATED CORRUGATED METAL PANEL

CONTINUOUS SEALANT

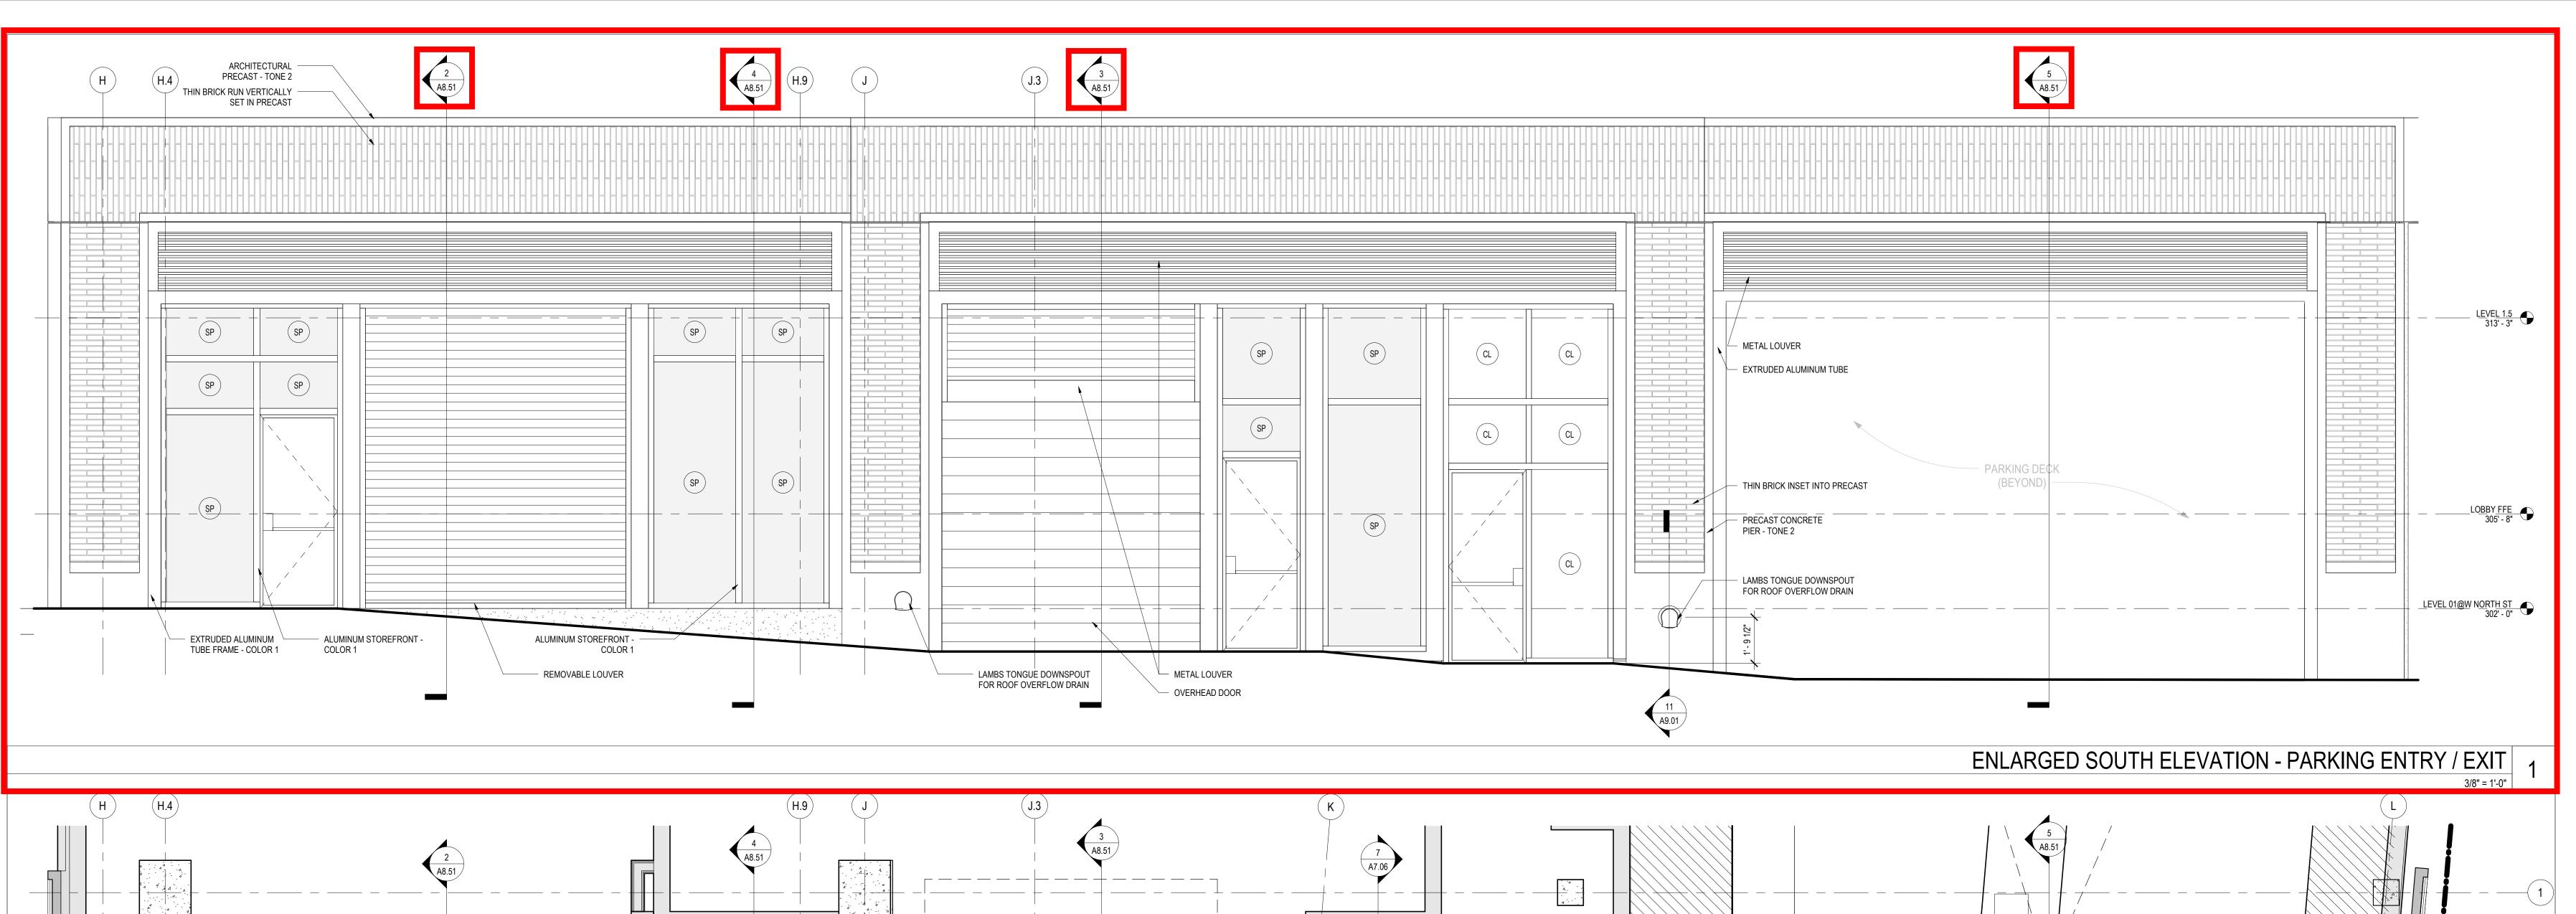

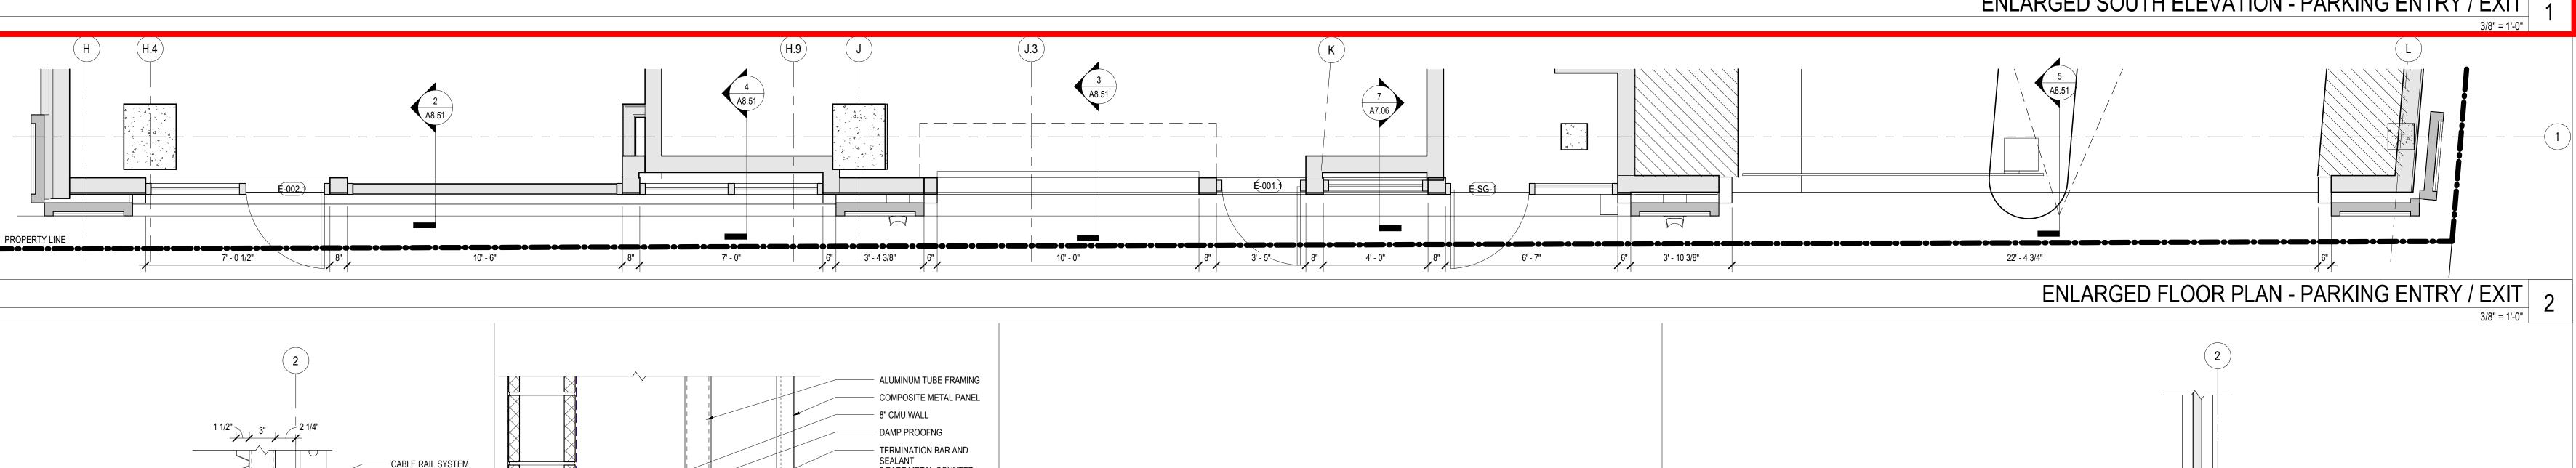

- CABLE RAIL SYSTEM


TRAFFIC COATING


1" REVEAL

FLASHING


INSULATION

SINGLE PLY ROOF -MEMBRANE COVER BOARD -

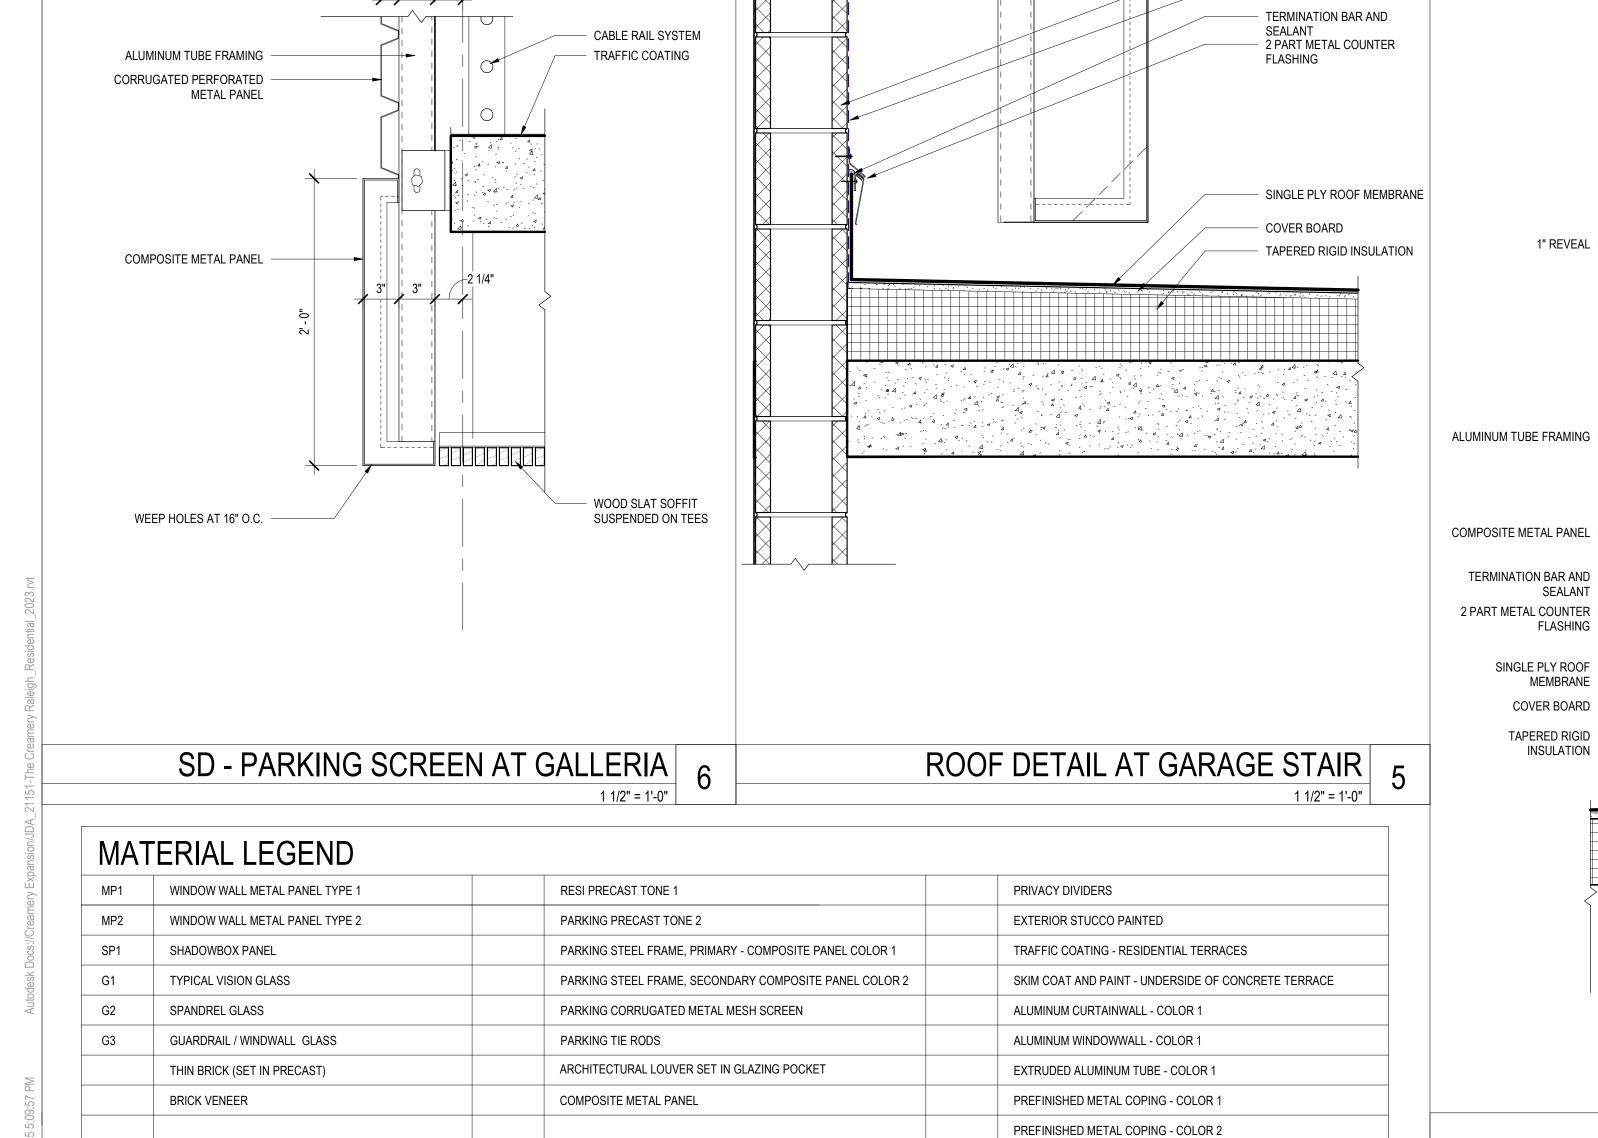

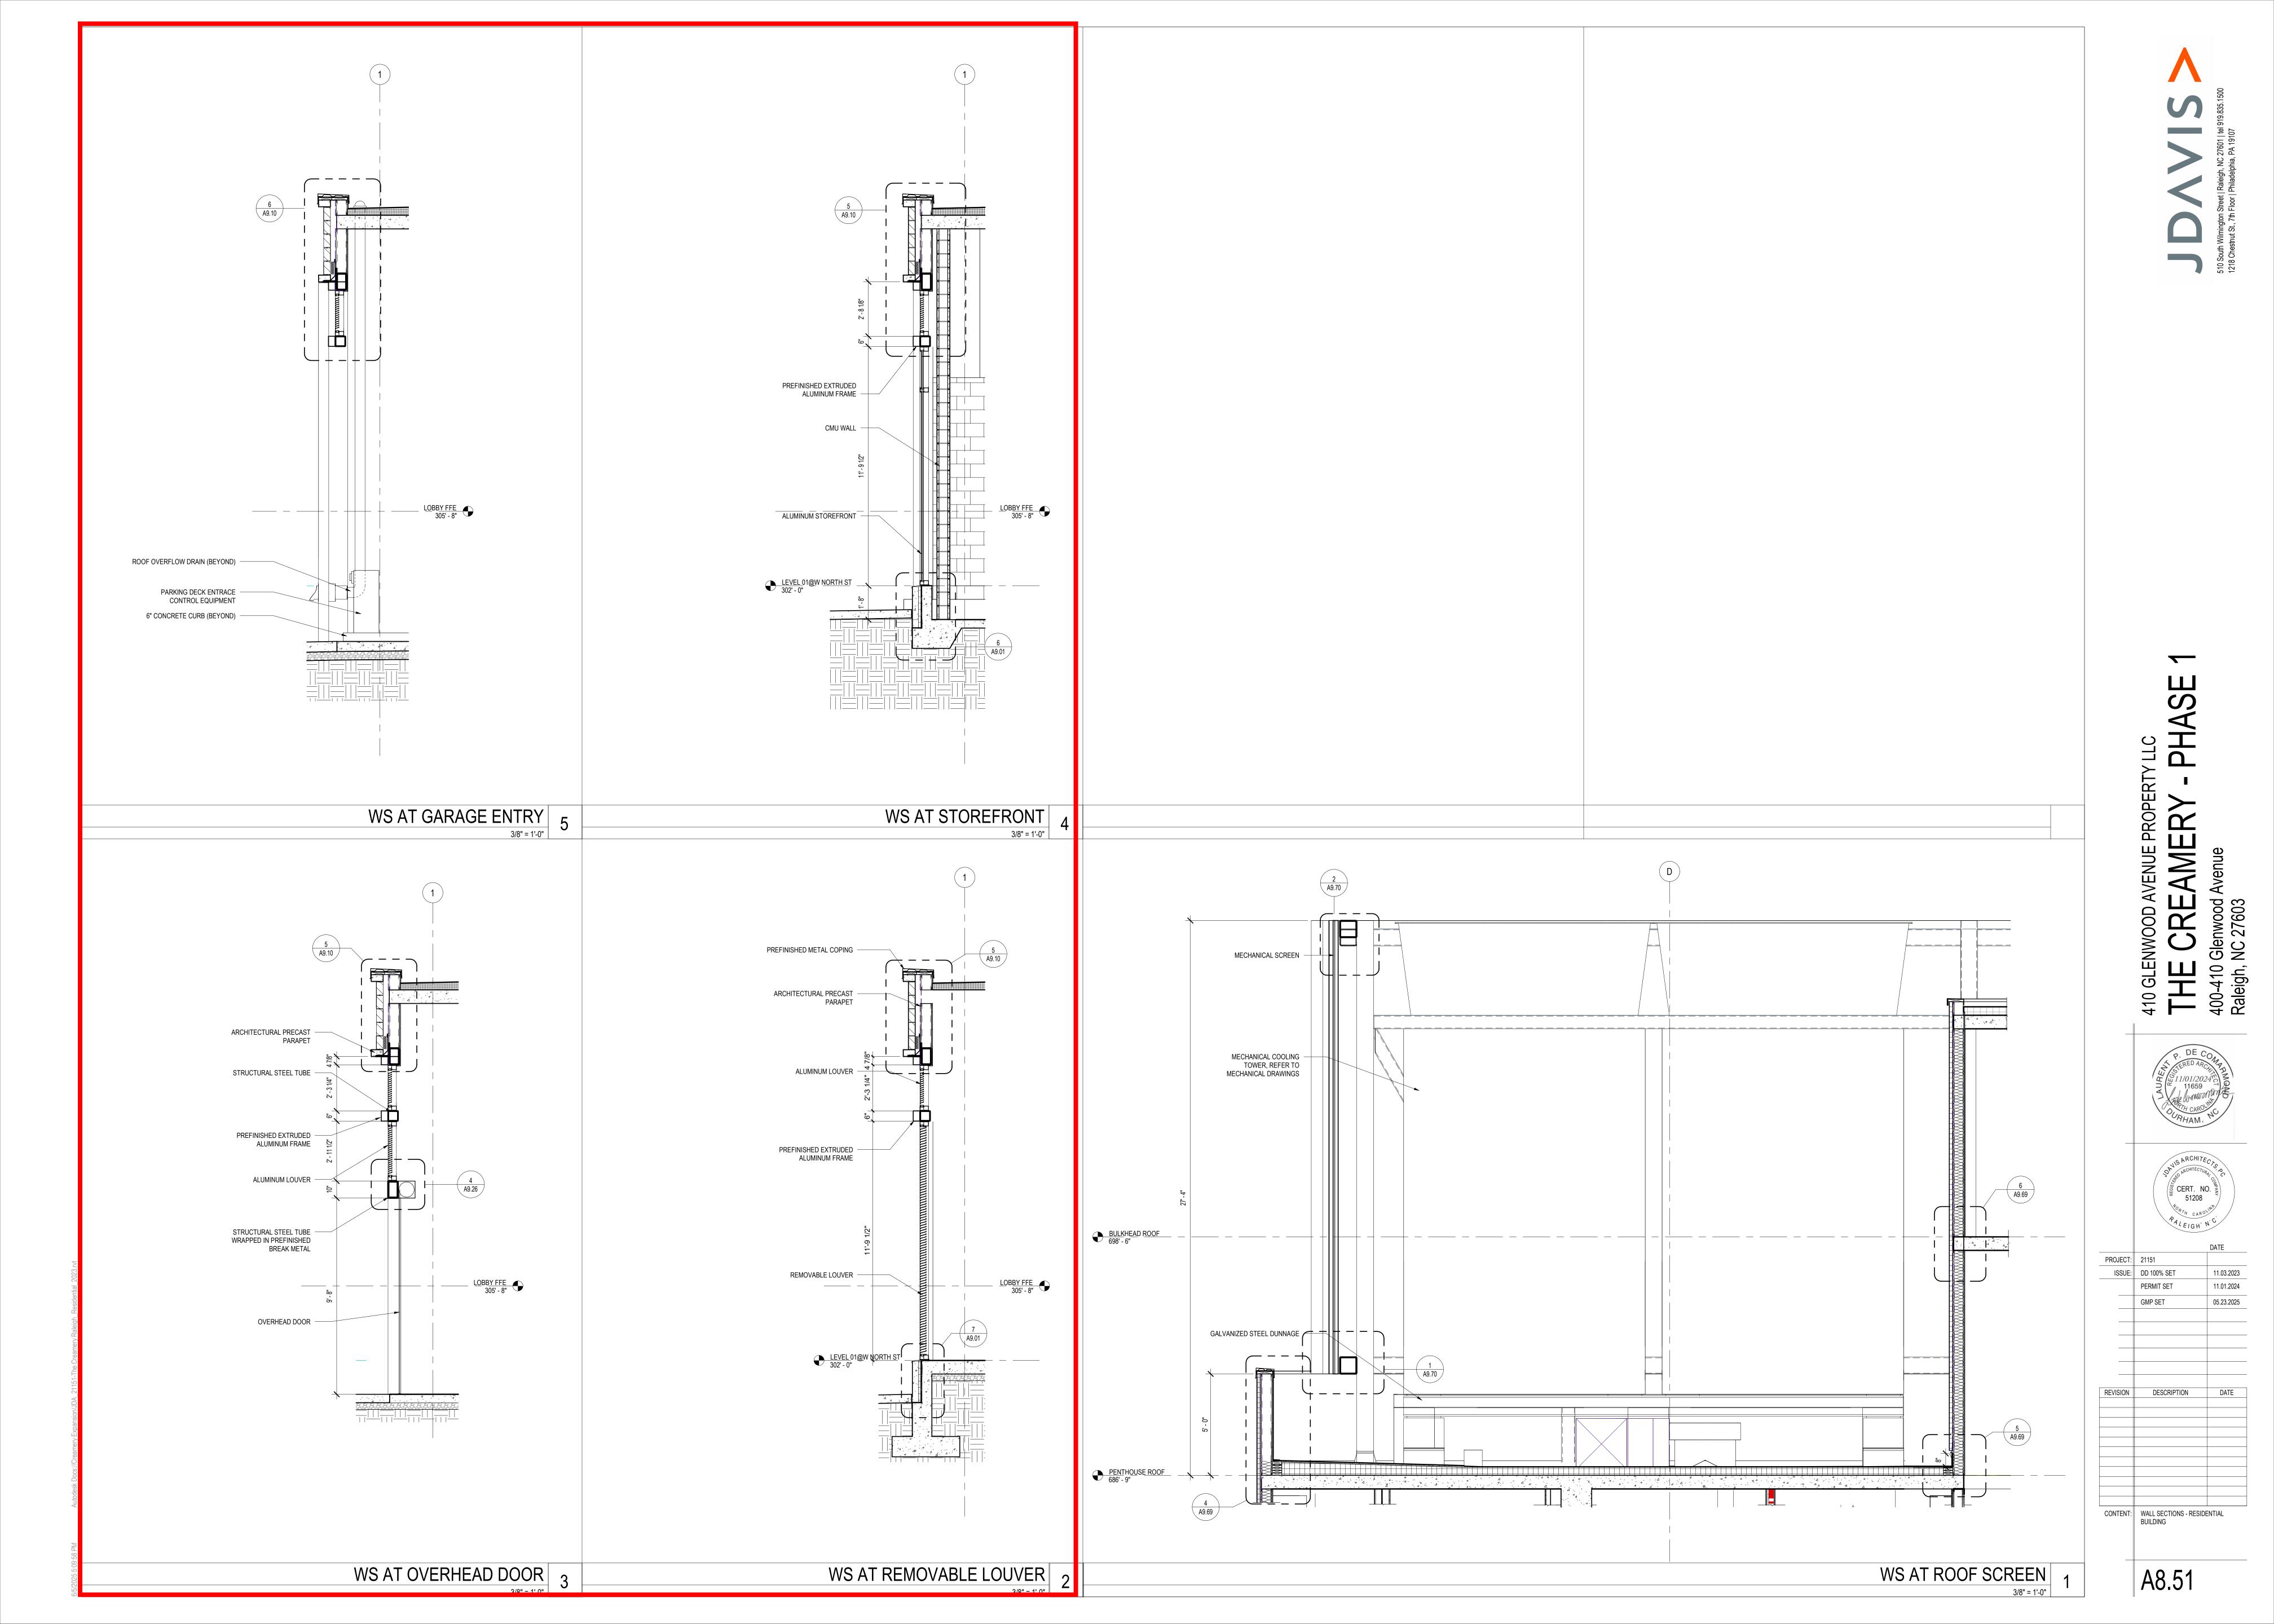


				DO	OOR SCHEDULE -	- COMMON DOORS							D	OOR SCHED	DULE - COMMON DOORS	<b>S</b>						DOC	OR SCHEDULE - COMMON DOORS		
		SIZE	T		CONSTRUC						SI	ZE			TRUCTION					SIZE			CONSTRUCTION		
O1@W N	ORTH ST	HEIGHT	THICKNES	SS FIRE RATIN	G PANEL F	FRAME HARDWARE	Location	Comments	Mark E	ELEV WID	TH HEIG	SHT   THICKN	NESS   FIRE RATIN	NG PANEL	FRAME HARDWA	ARE Location	Comments	Mark ELE	3' - 0"	H HEIGH	THICKNES	S FIRE RATING	PANEL FRAME HARDWA	RE Location	Comments
D	3' - 0"	7' - 6"	1 1/2"	0	AL AL		BFP		400A E	6' - 0"	7' - 4"	1 3/4"	45 MIN	НМ	HM	FIRE SERVICE LOBBY	PANIC HARDWARE	903 A	3' - 0"	7' - 4"	1 3/4"	45 MIN	HM HM	BDA/FIRE/TEL	
Α	3' - 0"	7' - 4"	1 3/4"	0	HM HM	1	LOADING CORRIDOR		400B E	6' - 0"	7' - 4"	1 3/4"	45 MIN	HM	HM	FIRE SERVICE LOBBY	PANIC HARDWARE	904 A	3' - 0"	7' - 4"	1 3/4"	90 MIN	HM HM	MECH	
A	3' - 0"	7' - 4"	1 3/4"	20 MIN	WD MT	L	ELEV. CONTROL RM		402 A	3' - 0"	7' - 4"	1 3/4"	90 MIN	HM	HM	ELEC PRACTICE		907A A	3' - 0"	7' - 4"	1 3/4"	45 MIN	HM HM	TRASH	
Н	10' - 0"	10' - 0"	3"	0	STL STL	1	GARAGE - TRANSFORMER GARAGE - TRANSFORMER		403 A 404 A	3' - 0"	7' - 4"	1 3/4" 1 3/4"	90 MIN	HM	HM HM	BDA/FIRE/TEL  MECH		907B A 912A E	6' - 0"	10' - 0"	1 3/4"	0	HM HM WD	TENANT STORAGE & PRV RESERVABLE ROOM	
D	3' - 0"	7' - 6"	1 1/2"	0	AL AL	_	OF WORKER CHANGE		407 A	3' - 0"	7' - 4"	1 3/4"	45 MIN	HM	HM	III. COLL		912B A	5' - 11"	8' - 0"	2"	0	AL AL	RESERVABLE ROOM	SEE INT ELEVS,
Α	3' - 0"	7' - 4"	1 3/4"	90 MIN	HM HM	1	GARAGE - RESI GENERATOR	PANIC HARDWARE	408A A	3' - 0"	7' - 4"	1 3/4"	20 MIN	HM	HM	ENTRY VESTIBULE		040	01 011	71 411	4.0/48	00 1 411	NA/D AATI	MENOWO	PANIC HARDWA
4	3' - 0"	7' - 4"	1 3/4"	90 MIN	HM HM	1	GARAGE - RETAIL/REST TRASH		408B D	3' - 0"	7' - 8"	1 1/2"	0	GL	AL	ENTRY VESTIBULE		913 A 914 A	3' - 0"	7' - 4"	1 3/4"	20 MIN 20 MIN	WD MIL	MENS WC WOMENS WC	
H F	6' - 0"	8' - 0"	1 3/4"	0	HM HM	L	GARAGE - RETAIL/REST TRASH GARAGE - STORAGE		409 E 410 A	3' - 0"	7' - 0"	1 3/4"	0	HM	HM	MAINTENANCE OFFICE		917A A	3' - 0"	7' - 4"	1 3/4"	20 MIN	WD MTL	CHANGING ROOM	
A	3' - 0"	7' - 4"	1 3/4"	90 MIN	HM HM	1	GARAGE - LOADING CORRIDOR		SA-4A A	3' - 0"	7' - 4"	1 3/4"	45 MIN	HM	HM	STAIR A	PANIC HARDWARE	E-913 D	3' - 0"	8' - 0"	1 1/2"	0	AL AL	SUMMER KITCHEN	PANIC HARDWA
Н	6' - 0"	7' - 0"	3"	90 MIN	STL STI	L	LOADING CORRIDOR		SA-4B A	3' - 0"	7' - 4"	1 3/4"	90 MIN	HM	НМ	STAIR A	PANIC HARDWARE	E-914B A	6' - 0"	8' - 0"	2"	0	AL AL	SUMMER KITCHEN	PANIC HARDWA
4	3' - 0"	7' - 4"	1 3/4"	90 MIN	HM HM	-	GARAGE - RESI TRASH BIN STORAGE		SB-4 A	3' - 0"	7' - 4"	1 3/4"	90 MIN	HM	HM	STAIR B	PANIC HARDWARE	SA-9A A	3' - 0"	7' - 4"	1 3/4"	90 MIN	HM HM	STAIR A	PANIC HARDWA
4	3' - 0" 6' - 0"	7' - 4"	1 3/4"	90 MIN	HM HM	1	GARAGE - RESI TRASH BIN STORAGE		SG-5 A	3' - 0"	7' - 4"	1 3/4"	90 MIN	HM	HM	STAIR C	PANIC HARDWARE	SA-9B A SB-9 A	3' - 0"	7' - 4"	1 3/4"	90 MIN 90 MIN	HM HM	STAIR A STAIR B	PANIC HARDWA PANIC HARDWA
H H	6' - 0"	/' - b"	3"	90 MIN 90 MIN	STI STI	L 1	GARAGE - RESI TRASH BIN STORAGE GARAGE - RESI TRASH BIN STORAGE		LEVEL 05 500A E	6' - 0"	7' - 4"	1 3/4"	45 MIN	НМ	HM	FIRE SERVICE LOBBY	PANIC HARDWARE	RESI LEVEL 10	J - 0	1 - 4	1 3/4	30 IVIIIV	I IIVI	OTAILL	TANICHARDWA
<u>'</u> )	3' - 0"	8' - 0"	1 1/2"	0	AL AL	_	EXIT PASSAGEWAY	PANIC HARDWARE	500A E	6' - 0"	7' - 4"	1 3/4"	45 MIN	HM	HM	FIRE SERVICE LOBBY	PANIC HARDWARE	1000A E	6' - 0"	7' - 4"	1 3/4"	45 MIN	HM HM	FIRE SERVICE LOBBY	PANIC HARDWA
	6' - 0"	8' - 0"	3"	90 MIN	STL STL	L	RESI TRASH		502 A	3' - 0"	7' - 4"	1 3/4"	90 MIN	HM	HM	ELEC		1000B E	6' - 0"	7' - 4"	1 3/4"	45 MIN	HM HM	FIRE SERVICE LOBBY	PANIC HARDWA
	3' - 0"	7' - 4"	1 3/4"	90 MIN	HM HM				503 A	3' - 0"	7' - 4"	1 3/4"	90 MIN	HM	HM	BDA/FIRE/TEL		1002 A	3' - 0"	7' - 4"	1 3/4"	90 MIN	HM HM	ELEC PDA/FIDE/TEL	
	3' - 0"	7' - 4"	1 3/4"	90 MIN	HM HM	1			504 A	3' - 0"	7' - 4"	1 3/4"	90 MIN	HM	HM	MECH		1003 A	3' - 0"	7' - 4"	1 3/4"	90 MIN	HM HM	BDA/FIRE/TEL MECH	
	3 - U" 3' - N"	1 - 4" 7' - Δ"	1 3/4"	90 MIN 90 MIN	HM HM	1			507 A 508A A	3' - 0" 3' <sub>-</sub> 0"	7' - 4"	1 3/4"	45 MIN 20 MIN	HM	HM HM	TRASH ENTRY VESTIBULE		1004 A 1007 A	3' - 0"	7' - 4"	1 3/4"	45 MIN	HM HM	TRASH	
	6' - 0 1/2"	8' - 0 1/4"	2"	0	AL AL		RETAIL 2	PANIC HARDWARE	508A A	3' - 0"	7' - 8"	1 1/2"	0	GL	AL	ENTRY VESTIBULE		SA-10A A	3' - 0"	7' - 4"	1 3/4"	45 MIN	HM HM	STAIR A	PANIC HARDWA
	6' - 0 1/2"	8' - 0 1/4"	2"	0	AL AL		RETAIL 2	PANIC HARDWARE	509 A	3' - 0"	7' - 4"	1 3/4"	20 MIN	НМ	HM	TENANT STORAGE		SA-10B A	3' - 0"	7' - 4"	1 3/4"	90 MIN	HM HM	STAIR A	PANIC HARDWA
	6' - 0"	8' - 0"	2"	0	AL AL		RETAIL 2	PANIC HARDWARE	510 A	3' - 0"	7' - 0"	1 3/4"	0	НМ	HM	DRY SPR		SB-10 A	3' - 0"	7' - 4"	1 3/4"	90 MIN	HM HM	STAIR B	PANIC HARDWA
			2"	0	AL AL		RETAIL 2	PANIC HARDWARE	1210 A	3' - 0"	7' - 0"	1 3/4"	0	HM	HM	CTAID A	DANIO LIABBIANE	RESI LEVEL 11 1100A E	בי חיי	7' 4"	1 3/4"	45 MIN	HM UM	FIRE SERVICE LOBBY	PANIC HARDW
	6' - 0 1/2" 6' - 0"	8' - 0 1/4" 8' - 0"	2"	U n	AL AL		RETAIL 2 RETAIL 3	PANIC HARDWARE PANIC HARDWARE	SA-5A A SA-5B A	3' - 0"	7' - 4"	1 3/4"	45 MIN	HIM	HM HM	STAIR A STAIR A	PANIC HARDWARE PANIC HARDWARE	1100A E	6' - 0"	7' - 4"	1 3/4"	45 MIN	HM HM	FIRE SERVICE LOBBY	PANIC HARDW
	6' - 0"	8' - 0"	2"	0	AL AL		RETAIL 3	PANIC HARDWARE PANIC HARDWARE	SA-5B A SB-5 A	3' - N"	7' - 4"	1 3/4"	90 MIN	HM	HM	STAIR B	PANIC HARDWARE	1100B L	3' - 0"	7' - 4"	1 3/4"	90 MIN	HM HM	ELEC ELEC	I AND HANDY
	3' - 0"	7' - 6"	1 1/2"	0	AL AL		GARAGE - STAIR	PANIC HARDWARE	SG-6 A	3' - 0"	7' - 4"	1 3/4"	90 MIN	HM	HM	STAIR C	PANIC HARDWARE	1103 A	3' - 0"	7' - 4"	1 3/4"	90 MIN	HM HM	BDA/FIRE/TEL	
_	3' - 0"	7' - 4"	1 3/4"	90 MIN	HM HM	1	STAIR B	PANIC HARDWARE	LEVEL 06					<u> </u>				1104 A	3' - 0"	7' - 4"	1 3/4"	90 MIN	HM HM	MECH	
S	SI LOBBY								600A E	6' - 0"	7' - 4"	1 3/4"	45 MIN	НМ	HM	FIRE SERVICE LOBBY	PANIC HARDWARE	1107 A	3' - 0"	7' - 4"	1 3/4"	45 MIN	HM HM	TRASH	DANIO
	4' - 0"	8' - 0"	1 3/4"	0	HM  HM	1	CORE - ELECTRIC & FIRE/BDA/TEL& STAIR A	PANIC HARDWARE	600B E	6' - 0"	7' - 4"	1 3/4"	45 MIN	HM	HM	FIRE SERVICE LOBBY	PANIC HARDWARE	SA-11A A SA-11B A	3' - 0"	7' - 4"	1 3/4"	45 MIN 90 MIN	HM HM	STAIR A STAIR A	PANIC HARD\ PANIC HARD\
	3' - 0"	7' - 4"	1 3/4"	90 MIN	HM HM	1	FIRE COMMAND		602 A	3' - U"	7' - 4"	1 3/4" 1 3/4"	90 MIN 90 MIN	HIVI	HM HM	BDA/FIRE/TEL		SB-11B A	3' - 0"	7 - 4	1 3/4"	90 MIN	HM HM	STAIR B	PANIC HARDV
	6' - 0"	9' - 2"	2"	0	AL AL		LOBBY VESTIBULE	PANIC HARDWARE	604 A	3' - 0"	7' - 4"	1 3/4"	90 MIN	HM	HM	MECH		RESI LEVEL 12	1.5	<u>'</u>	· • · ·			1	
	3' - 0"	7' - 4"	1 3/4"	0	WD HM	1	PACKAGE ROOM		607A A	3' - 0"	7' - 4"	1 3/4"	45 MIN	HM	HM	TRASH		1200A E	6' - 0"	7' - 4"	1 3/4"	45 MIN	HM HM	FIRE SERVICE LOBBY	PANIC HARDV
	3' - 0"	7' - 4"	1 3/4"	20 MIN	WD MT		STORAGE		608A A	3' - 0"	7' - 4"	1 3/4"	20 MIN	НМ	HM	ENTRY VESTIBULE		1200B E	6' - 0"	7' - 4"	1 3/4"	45 MIN	HM HM	FIRE SERVICE LOBBY	PANIC HARDV
	3' - 0"	7' - 4"	1 3/4"	20 MIN	WD MT	L	STORAGE	OFF BIT FI FI (C	608B D	3' - 0"	7' - 8"	1 1/2"	0	GL	AL	ENTRY VESTIBULE		1202 A	3' - 0"	7' - 4"	1 3/4"	90 MIN	HM HM	ELEC	
	3' - 0"	8' - 0"	1 1/2"	0	GL AL	4	LEASING LOBBY	SEE INT ELEVS	609 A	3' - 0"	7' - 4"	1 3/4"	20 MIN	HM	HM	TENANT STORAGE		1203 A	3' - 0"	7' - 4"	1 3/4"	90 MIN	HM HM	BDA/FIRE/TEL	
	3' - U"	δ - U" 7' - 10"	1 3/4"	n	WD HM	1	LEASING PANTRY LEASING OFFICE 1	SEE INT ELEVS	610 A SA-6A A	3' - 0"	7' - 0"	1 3/4"	0 45 MAIN!	HM	HM	DRY SPR	DANIO LIADDIAIADE	1204 A 1207A A	3' - U"	7' - 4"	1 3/4"	90 IVIIN 45 MINI	HM HM	MECH TRASH	
	3' - 0"	7 - 10"	1 1/2"	0	GL AL		LEASING OFFICE 2	SEE INT ELEVS	SA-6A A SA-6B A	3' - 0"	7' - 4"	1 3/4"	90 MIN	HM	HM HM	STAIR A STAIR A	PANIC HARDWARE PANIC HARDWARE	1207A A	3' - 0"	7' - 4"	1 3/4"	0	HM HM	TENANT STORAGE & PRV	
	6' - 0"	9' - 0"	2"	0	AL AL		LOBBY VESTIBULE	PANIC HARDWARE	SB-6 A	3' - 0"	7' - 4"	1 3/4"	90 MIN	HM	HM	STAIR B	PANIC HARDWARE	SA-12A A	3' - 0"	7' - 4"	1 3/4"	45 MIN	HM HM	STAIR A	PANIC HARDW
	3' - 0"	8' - 0"	1 3/4"	90 MIN	HM HM	1	CORE - ELECTRIC & FIRE/BDA/TEL&	PANIC HARDWARE	SG-7 A	3' - 0"	7' - 4"	1 3/4"	90 MIN	НМ	HM	STAIR C	PANIC HARDWARE	SA-12B A	3' - 0"	7' - 4"	1 3/4"	90 MIN	HM HM	STAIR A	PANIC HARDW
	2! 0"	יי סי	1 2//"	OO MINI		A	STAIR A  CORE - ELECTRIC & FIRE/BDA/TEL&	PANIC HARDWARE	LEVEL 07									SB-12 A	3' - 0"	7' - 4"	1 3/4"	90 MIN	HM HM	STAIR B	PANIC HARDV
	3 - 0	0 - 0	1 3/4	30 IVIIIN	T IIVI	'1	STAIR A	FAINICTIANDWANL	700A E	6' - 0"	7' - 4"	1 3/4"	45 MIN	HM	HM	FIRE SERVICE LOBBY	PANIC HARDWARE	RESI LEVEL 13	6' - 0"	7' - 1''	1 3/4"	45 MIN	HM HM	FIRE SERVICE LOBBY	PANIC HARDV
									700B E	0 - U 3' - O"	7 - 4 7' - 1''	1 3/4" 1 3/4"	45 MIN	HM	HM HM	FIRE SERVICE LOBBY ELEC	PANIC HARDWARE	1300A E	6' - 0"	7' - 4"	1 3/4"	45 MIN	HM HM	FIRE SERVICE LOBBY	PANIC HARDV
	3' - 0"	7' - 4"	1 3/4"	90 MIN	HM HM	1	EMERGENCY ELEC		702 A	3' - 0"	7' - 4"	1 3/4"	90 MIN	HM	HM	BDA/FIRE/TEL		1302 A	3' - 0"	7' - 4"	1 3/4"	90 MIN	HM HM	ELEC	
	3' - 0"	7' - 0"	1 3/4"	0 00 00 00	HM HM	1	BOH  DESI & DETAIL MAIN ELEC		704 A	3' - 0"	7' - 4"	1 3/4"	90 MIN	НМ	HM	MECH		1303 A	3' - 0"	7' - 4"	1 3/4"	90 MIN	HM HM	BDA/FIRE/TEL	
	6' - 0" 3' - 0"	σ - U" 7' - Λ"	1 3/4"	90 MIN 90 MIN	HM HM	и Л	RESI & RETAIL MAIN ELEC STAIR B	PANIC HARDWARE	707 A	3' - 0"	7' - 4"	1 3/4"	45 MIN	НМ	НМ	TRASH		1304 A	3' - 0"	7' - 4"	1 3/4"	90 MIN	HM HM	MECH	
		1 - <del>4</del>	1 0/4	JO IVIIIN	T 11VI	·	Onanto	I ANIO HANDWAKE	708A A	3' - 0"	7' - 4"	1 3/4"	20 MIN	HM	HM	ENTRY VESTIBULE		1307 A	3' - 0"	7' - 4"	1 3/4"	45 MIN	HM HM	TRASH	DANIO LIADO
	6' - 0"	7' - 4"	1 3/4"	45 MIN	HM HM	1	FIRE SERVICE LOBBY	PANIC HARDWARE	708B D	3' - 0"	7' - 8"	1 1/2"	0 0	GL	AL	ENTRY VESTIBULE		SA-13A A SA-13B A	3 - 0" 3' - 0"	7' - 4"	1 3/4"	VIIIVI CH	HM HM	STAIR A STAIR A	PANIC HARD\ PANIC HARD\
	6' - 0"	7' - 4"	1 3/4"	45 MIN	HM HM	1	FIRE SERVICE LOBBY	PANIC HARDWARE	710 A	3 - U" 3' _ N"	7' - 4"	1 3/4"	2U IVIIIN	HM	HM HM	DRY SPR		SB-13 A	3' - 0"	7' - 4"	1 3/4"	90 MIN	HM HM	STAIR B	PANIC HARDI
	3' - 0"	7' - 4"	1 3/4"	90 MIN	HM HM	1	ELEC PRACTED		SA-7A A	3' - 0"	7' - 4"	1 3/4"	45 MIN	HM	HM	STAIR A	PANIC HARDWARE	RESI LEVEL 14					· · · · · · · · · · · · · · · · · · ·		
-	3' - 0"	7' 4"	1 3/4"	90 MIN	HIVI HM	/1 /	BDA/FIRE/TEL MECH		SA-7B A	3' - 0"	7' - 4"	1 3/4"	90 MIN	НМ	HM	STAIR A	PANIC HARDWARE	1400A E	6' - 0"	7' - 4"	1 3/4"	45 MIN	HM HM	FIRE SERVICE LOBBY	PANIC HARDV
	3' - 0"	7' - 4"	1 3/4"	45 MIN	HM HM	1	TRASH		SB-7 A	3' - 0"	7' - 4"	1 3/4"	90 MIN	НМ	HM	STAIR B	PANIC HARDWARE	1400B E	6' - 0"	7' - 4"	1 3/4"	45 MIN	HM HM	FIRE SERVICE LOBBY	PANIC HARD\
	3' - 0"	7' - 4"	1 3/4"	0	HM HM	1	TENANT STORAGE & PRV		SG-8 A	3' - 0"	7' - 4"	1 3/4"	90 MIN	HM	HM	STAIR C	PANIC HARDWARE	1402 A 1403 A	3' - U"	7' 4"	1 3/4"	OU MINI	HM HM	BDA/FIRE/TEL	
	3' - 0"	7' - 4"	1 3/4"	20 MIN	HM HM	1	ENTRY VESTIBULE & BIKE STORAGE		LEVEL 08 800A E	6' - N"	7' _ 1"	1 3/4"	45 MIN	НМ	HM	FIRE SERVICE LOBBY	PANIC HARDWARE	1403 A	3' - 0"	7' - 4"	1 3/4"	90 MIN	HM HM	MECH	
_	3' - 0"	7' - 8"	1 1/2"	0	GL AL		ENTRY VESTIBULE		800B E	6' - 0"	7' - 4"	1 3/4"	45 MIN	HM	HM	FIRE SERVICE LOBBY	PANIC HARDWARE	1407A A	3' - 0"	7' - 4"	1 3/4"	45 MIN	HM HM	TRASH	
	3' - 0"	7' - 4"	1 3/4"	20 MIN	HM HM	1	ENTRY VESTIBULE & BIKE STORAGE		802 A	3' - 0"	7' - 4"	1 3/4"	90 MIN	НМ	HM	ELEC		1407B A	3' - 0"	7' - 4"	1 3/4"	0	HM HM	TENANT STORAGE & PRV	
	3' - N"	ι - U 7' - Δ"	1 3/4"	90 MINI	HM HM	-	DRY SPR STAIR PRESSURIZATION FAN		803 A	3' - 0"	7' - 4"	1 3/4"	90 MIN	НМ	HM	BDA/FIRE/TEL		SA-14A A	3' - 0"	7' - 4"	1 3/4"	45 MIN	HM HM	STAIR A	PANIC HARD
	3' - 0"	7' - 0"	1 3/4"	0	HM HM		5.7 TRESOURIZATION LAW		804 A	3' - 0"	7' - 4"	1 3/4"	90 MIN	HM	HM	MECH TRASH		SA-14B A	3' - 0"	7' - 4"	1 3/4"	90 MIN 90 MIN	HM HM	STAIR A STAIR B	PANIC HARD\ PANIC HARD\
	3' - 0"	7' - 4"	1 3/4"	45 MIN	HM HM		STAIR A	PANIC HARDWARE	807A A 808A A	3' - 0"	7' - 4"	1 3/4"	45 MIN	HM	HM HM	TRASH ENTRY VESTIBULE		SB-14 A RESI LEVEL 15	J - U	7' - 4"	1 3/4"	VIIIIVI UE	IVII IVII IVII I	OIMIND	FAINIC HARDI
	3' - 0"	7' - 4"	1 3/4"	90 MIN	HM HM	1	STAIR A	PANIC HARDWARE	808A A 808B D	3' - 0"	7' - 8"	1 1/2"	0	GL	AL	ENTRY VESTIBULE		1500A E	6' - 0"	7' - 4"	1 3/4"	45 MIN	HM HM	FIRE SERVICE LOBBY	PANIC HARD\
	3' - 0"	7' - 4"	1 3/4"	90 MIN	HM HM	1	STAIR B	PANIC HARDWARE	809 A	3' - 0"	7' - 4"	1 3/4"	20 MIN	HM	HM	TENANT STORAGE		1500B E	6' - 0"	7' - 4"	1 3/4"	45 MIN	HM HM	FIRE SERVICE LOBBY	PANIC HARDI
_	3' - U"	7' 4"	1 3/4"	90 MIN 90 MIN	HM HM	/1 /	STAIR C STAIR C	PANIC HARDWARE	810 A	3' - 0"	7' - 0"	1 3/4"	0	НМ	НМ			1502 A	3' - 0"	7' - 4"	1 3/4"	90 MIN	HM HM	ELEC	
	3' - 0"	7' - 4"	1 3/4"	90 MIN	HM HM	•	STAIR C	PANIC HARDWARE PANIC HARDWARE	G801A E	5' - 0"	7' - 4"	1 3/4"	0	HM	HM	POOL EQUIPMENT		1503 A	3' - 0"	7' - 4"	1 3/4"	90 MIN	HM HM	BDA/FIRE/TEL	
	3' - 0"	7' - 4"	1 3/4"	90 MIN	HM HM		STAIR C	PANIC HARDWARE	G801B E	6' - 0"	7' - 4"	1 3/4"	90 MIN	HM	HM	POOL CHEMICAL STORAGE		1504 A 1507 A	3' - 0"	7' 4"	1 3/4"	90 MIN 45 MIN	HM HM	MECH TRASH	
			1						G802 A SA-8A A	3' - 0" 3' - 0"	/' - U"	1 3/4"	U AE MINI	HIVI	HM HM	DECK ELECTRICAL STAIR A	PANIC HARDWARE	SA-15A A	3' - N"	7' - 4"	1 3/4"	45 MIN	HM HM	STAIR A	PANIC HARDV
	6' - 0"	7' - 4"	1 3/4"	45 MIN	HM HM		FIRE SERVICE LOBBY	PANIC HARDWARE	SA-8A A SA-8B A	3' - 0"	7' - Δ"	1 3/4"	90 MIN	HM	HM	STAIR A	PANIC HARDWARE PANIC HARDWARE	SA-15B A	3' - 0"	7' - 4"	1 3/4"		HM HM	STAIR A	PANIC HARDV
	6' - 0"	7' - 4"	1 3/4"	45 MIN	HM HM		FIRE SERVICE LOBBY	PANIC HARDWARE	SB-8 A	3' - 0"	7' - 4"	1 3/4"	90 MIN	HM	HM	STAIR B	PANIC HARDWARE	SB-15 A	3' - 0"	7' - 4"	1 3/4"		HM HM	STAIR B	PANIC HARDV
	3' - 0" 3' - 0"	7' - 4" 7' - 4"	1 3/4"	90 MIN	HM HM		ELEC BDA/FIRE/TEL		SG8B A	3' - 0"	7' - 4"	1 3/4"	90 MIN	НМ	НМ	STAIR C	PANIC HARDWARE	RESI LEVEL 16					1		
	3' - 0"	7' - 4"	1 3/4"	90 MIN 90 MIN	HM HM		MECH MECH		SG8C A	3' - 0"	7' - 4"	1 3/4"	90 MIN	НМ	HM	STAIR C	PANIC HARDWARE	1600A E	6' - 0"	7' - 4"	1 3/4"		HM HM	FIRE SERVICE LOBBY	PANIC HARDY
	3' - 0"	7' - 4"	1 3/4"	45 MIN	HM HM		TRASH		LEVEL 09	a. a		4.0	45.00	1.15.4	LINA	FIDE OFFI "OF 1 OFFI '		1600B E 1602 A	6' - 0" 3' - 0"	7' - 4" 7' - 4"	1 3/4"		HM HM	FIRE SERVICE LOBBY	PANIC HARDV
	3' - 0"	7' - 4"	1 3/4"	20 MIN	HM HM				900A E 900B E	6' - 0"	7' - 4"	1 3/4"	45 MIN 45 MIN	HM HM	HM	FIRE SERVICE LOBBY		1002 A	J - U"	r - 4°	1 3/4"	NIIIVI OE	HM HM	ELEC	
	3' - 0"	7' - 0"	1 3/4"	0	HM HM	1			auud E	o - U"	1 - 4"	1 3/4"	VIIIVI C <del>P</del>	ΠIVI	HM	FIRE SERVICE LOBBY									
		7' - 4"	1 3/4"	45 MIN	HM HM	1	STAIR A	PANIC HARDWARE																	
	3' - 0"	<b>-71</b> /···	1 3/4"	90 MIN	HM HM	/1 /	STAIR A STAIR B	PANIC HARDWARE PANIC HARDWARE																	
	3' - 0" 3' - 0"	7' - 4"		OU MINI	HIV/I	a i	1011000	IL ADIL HARDWARE																	
	3' - 0" 3' - 0" 3' - 0" 3' - 0"	7' - 4" 7' - 4" 7' - 4"	1 3/4"	90 MIN 90 MIN	HM HM	1	STAIR C	PANIC HARDWARE																	

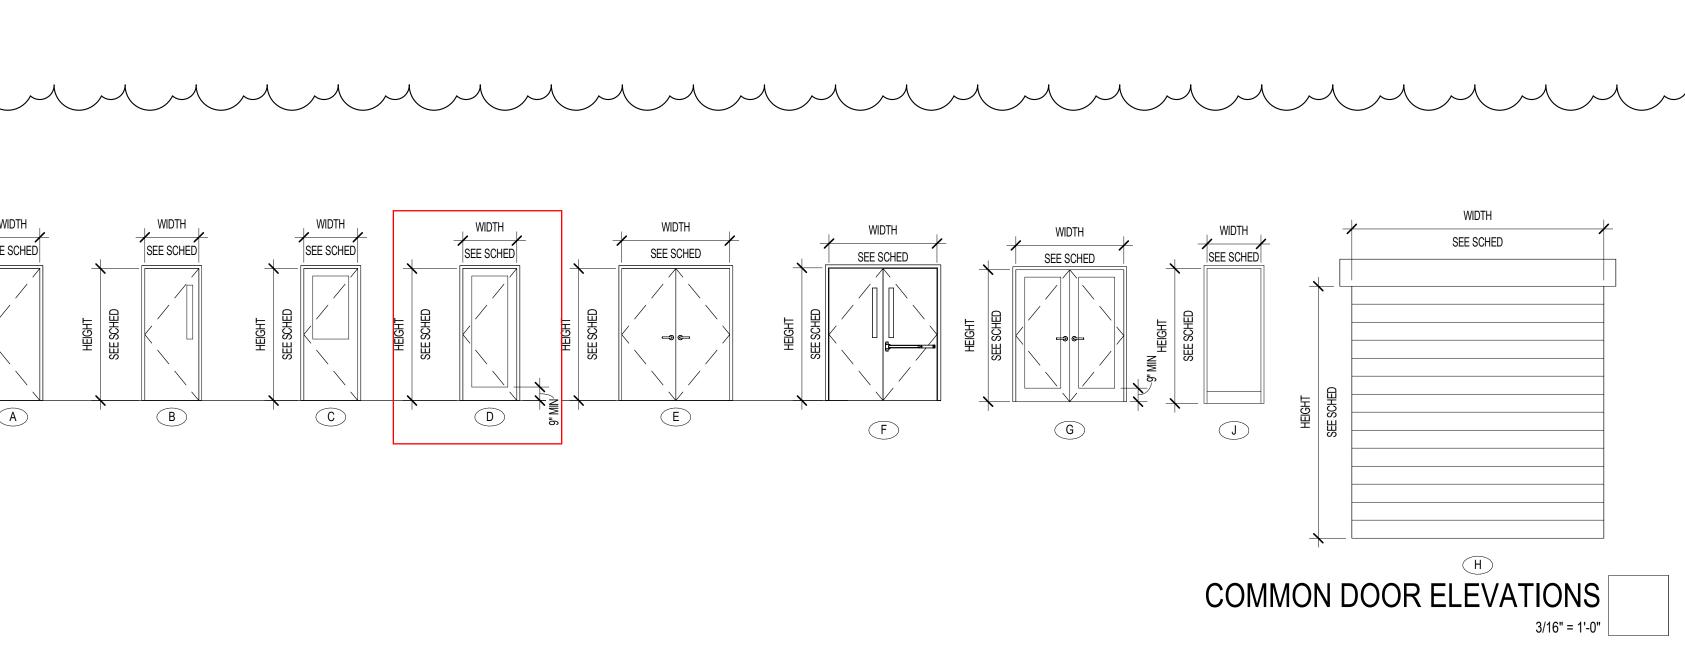

510 South Wilmington Street | Raleigh, NC 27601 | tel 919.835.1500 1218 Chestnut St., 7th Floor | Philadelphia, PA 19107

HE CREAMERY - PHASI

P. DE COMPANION DISTRIBUTION OF THE CAROLLE OF THE

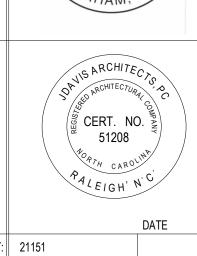


TECTS EXPRESSLY RESERVES ITS COMMON LAW COPYRIGHT AN

THECTS EXPRESSLY RESERVES ITS COMMON LAW COPYRIGHT AN

THE PROPERTY OF THE PRO

A11.02

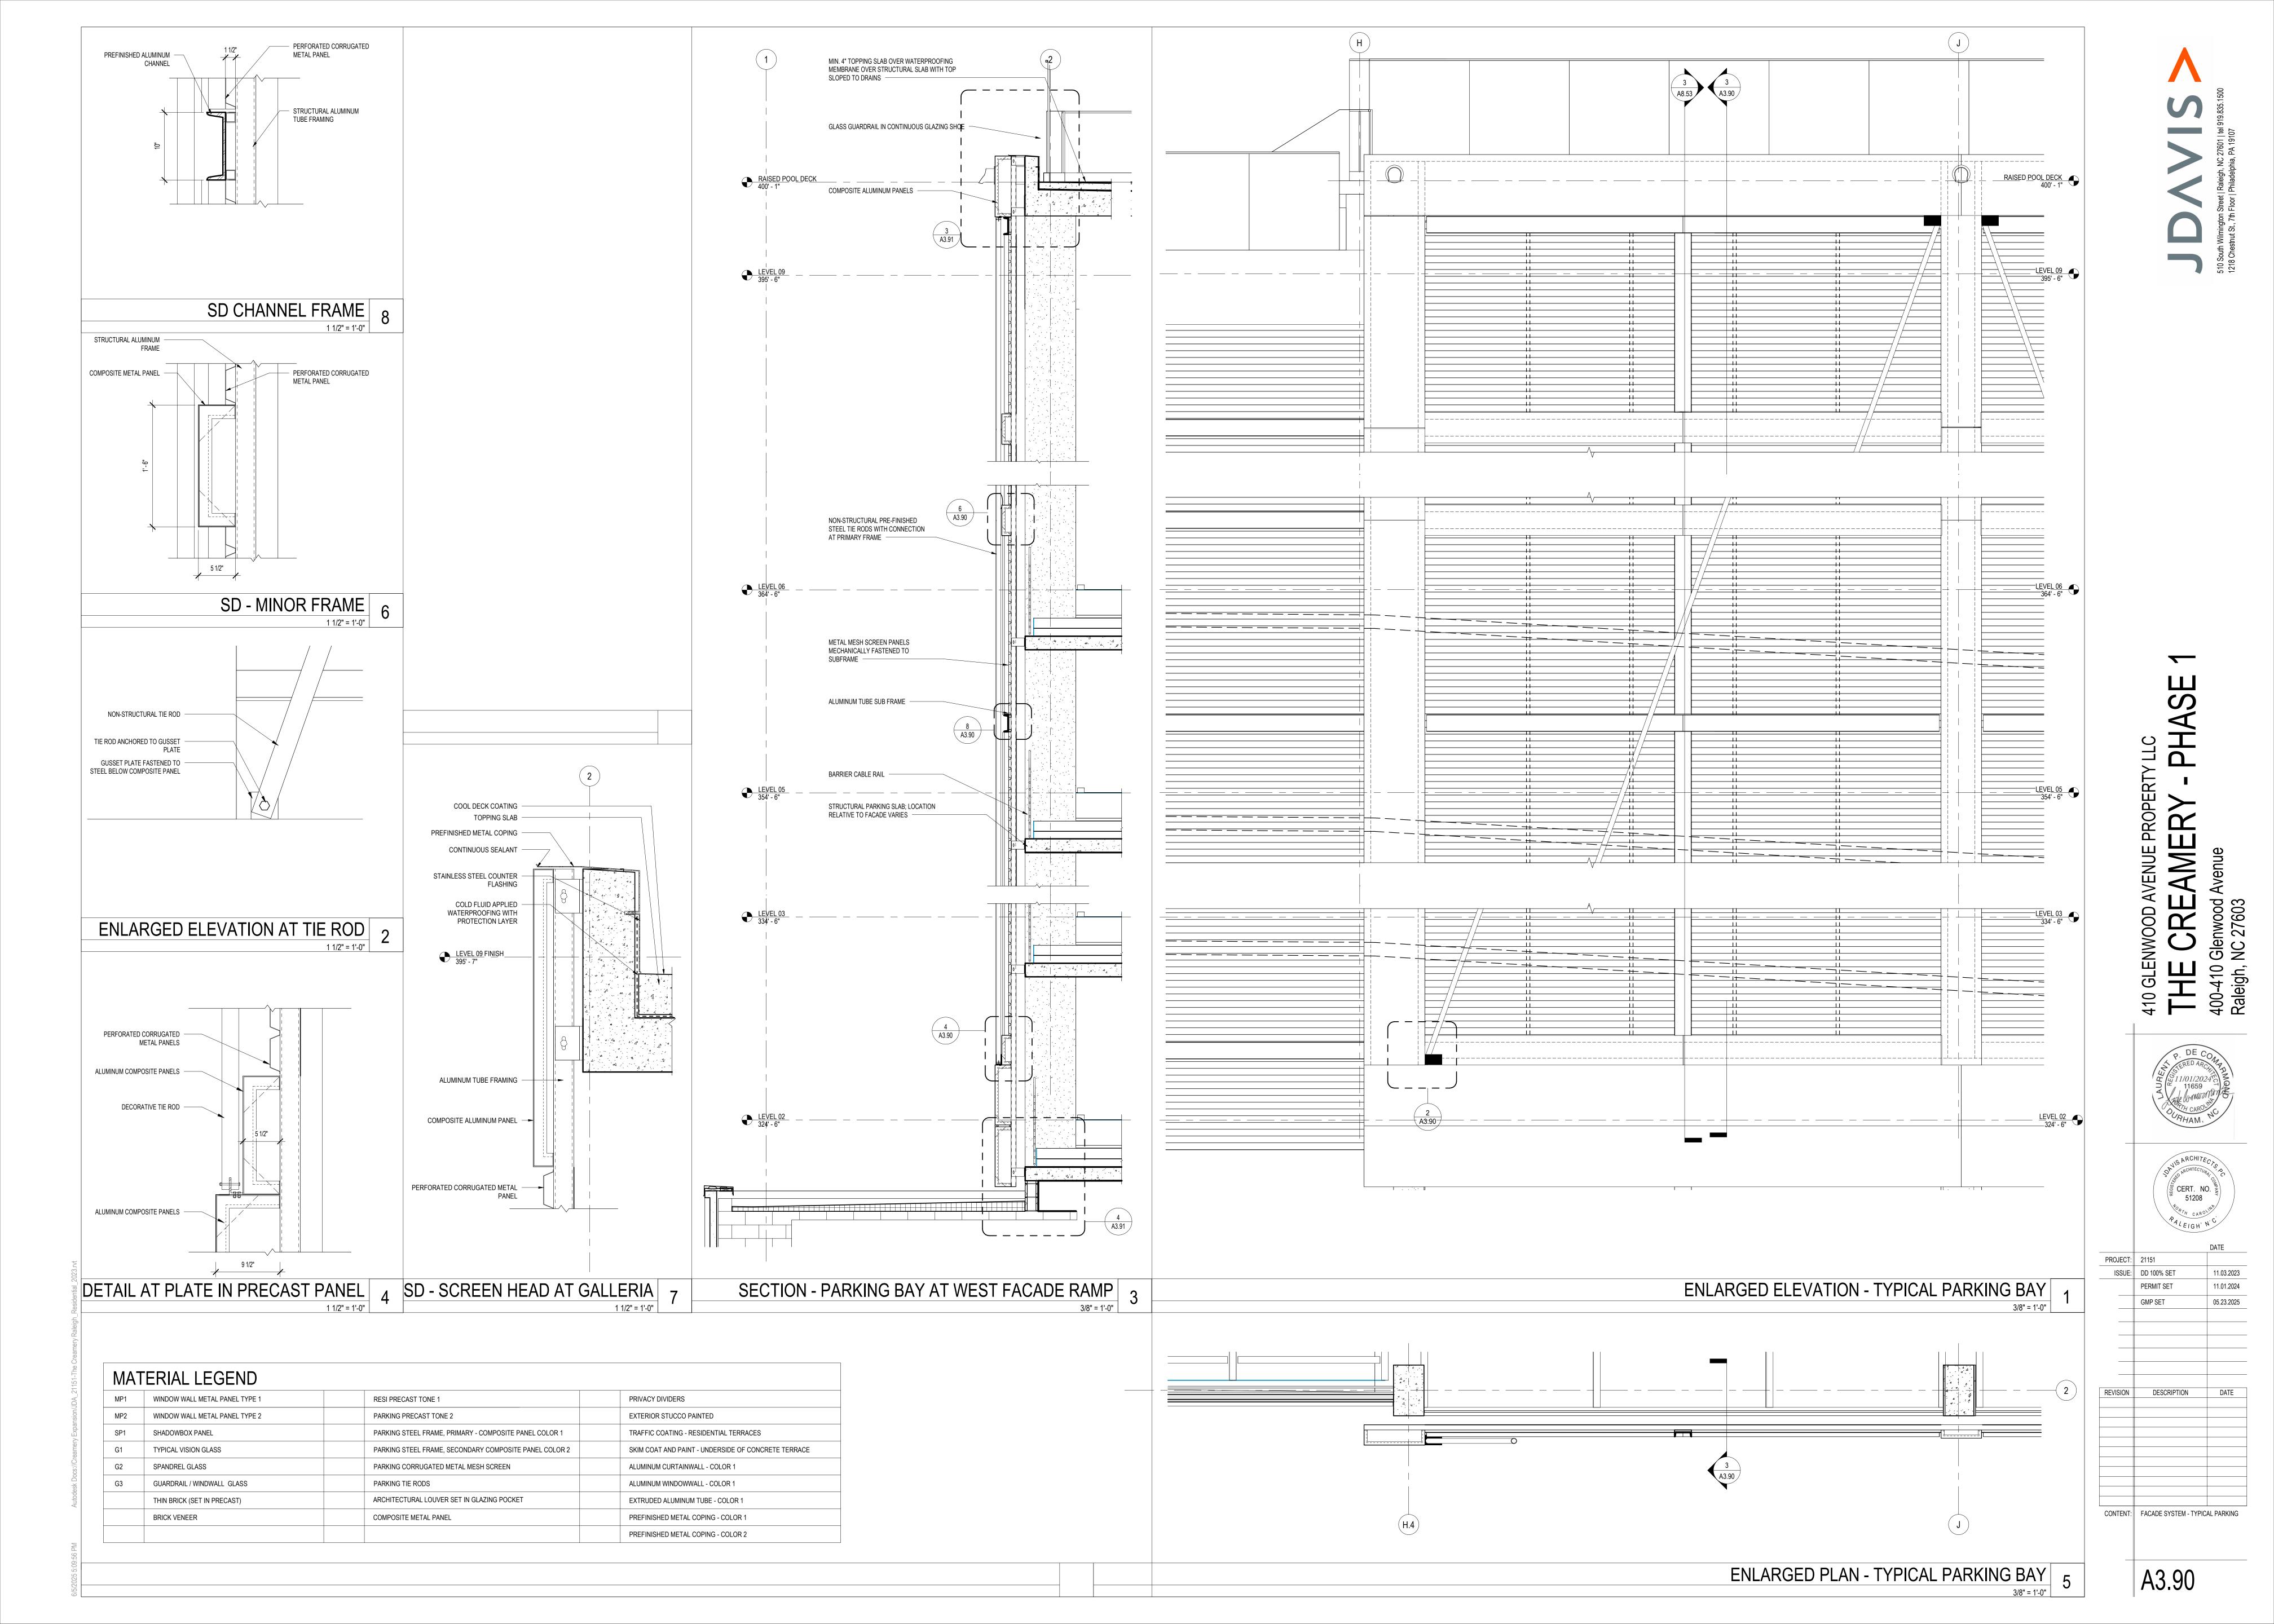

## THE CREAMERY

400-410 GLENWOOD AVE, RALEIGH, NC



COLOR	LEGEND
C ORRUGATED PANELS	TBD
FRAMING	TBD
HARDWARE	TBD

CORRUGATION PROFILE

TB D

PERFORATION PATTERN

TB D

	Submittal	
Date	Revision	Southeastern Architectural
03.14.2025	REVISION 3	Systems 9325 Forsyth Park Drive
		Charlotte, NC 28273  WWW.SEAS—TR.COM
		OFFICE: 704-896-5805
		Drawn By:
		Emma Branton—Harrell

#### GENERAL NOTES


- SEAS HAS PREPARED THESE SHOP DRAWINGS FOR THE PURPOSE OF ASSESSING CONFORMANCE TO THE CONTRACT DOCUMENTS AND FOR CONSTRUCTION COORDINATION
- THESE DOCUMENTS ARE PROPERTY OF SEAS AND CONTAIN PRIVILEGED INFORMATION WHICH MAY BE USED ONLY BY AUTHORIZED AGENTS. UNAUTHORIZED USE OR DISCLOSURE IS STRICTLY PROHIBITED.
- THESE SHOP DRAWINGS REPRESENT SEAS INTERPRETATION OF THE APPLICATION IN SEAS SYSTEM TO THIS PROJECT COMPLIANCE WITH ARCHITECTURAL DRAWINGS AND SPECIFICATIONS.IT IS IMPORTANT FOR THESE SHOP DRAWINGS BE REVIEWS BY THE CONTRACTOR AND ARCHITECT FOR PROPER COORDINATION.
- FIELD VERIFICATION OF BUILDING DIMENSIONS REQUIRED PRIOR TO FABRICATION.


#### MATERIALS


- 2"  $\times$  3"  $\times$   $\frac{1}{8}$ " ALUMINUM TUBES
- 2" X 4" X  $\frac{1}{8}$ " ALUMINUM TUBES
- 2"  $\times$  6"  $\times$   $\frac{1}{8}$ " ALUMINUM TUBES
- 2" X 7" X  $\frac{1}{8}$ " ALUMINUM BRACKETS
- 2" X 2" 1" ALUMINUM BRACKETS
- 5" X 3" X 3" ALUMINUM BRACKETS
- 4MM ALUMINUM COMPOSITE PANELS
- CORRUGATED PERFORATED PANELS
- 10" ALUMINUM CHANNELS
- $\frac{1}{2}$  Ø X 3  $\frac{1}{2}$  S.S. THRU BOLTS
- 3" Ø X 3" CONCRETE SCREW BOLTS
- #12 COUNTERSUNK TEK SCREWS
- #12 FLANGED TEK SCREW

SHEET #

G100

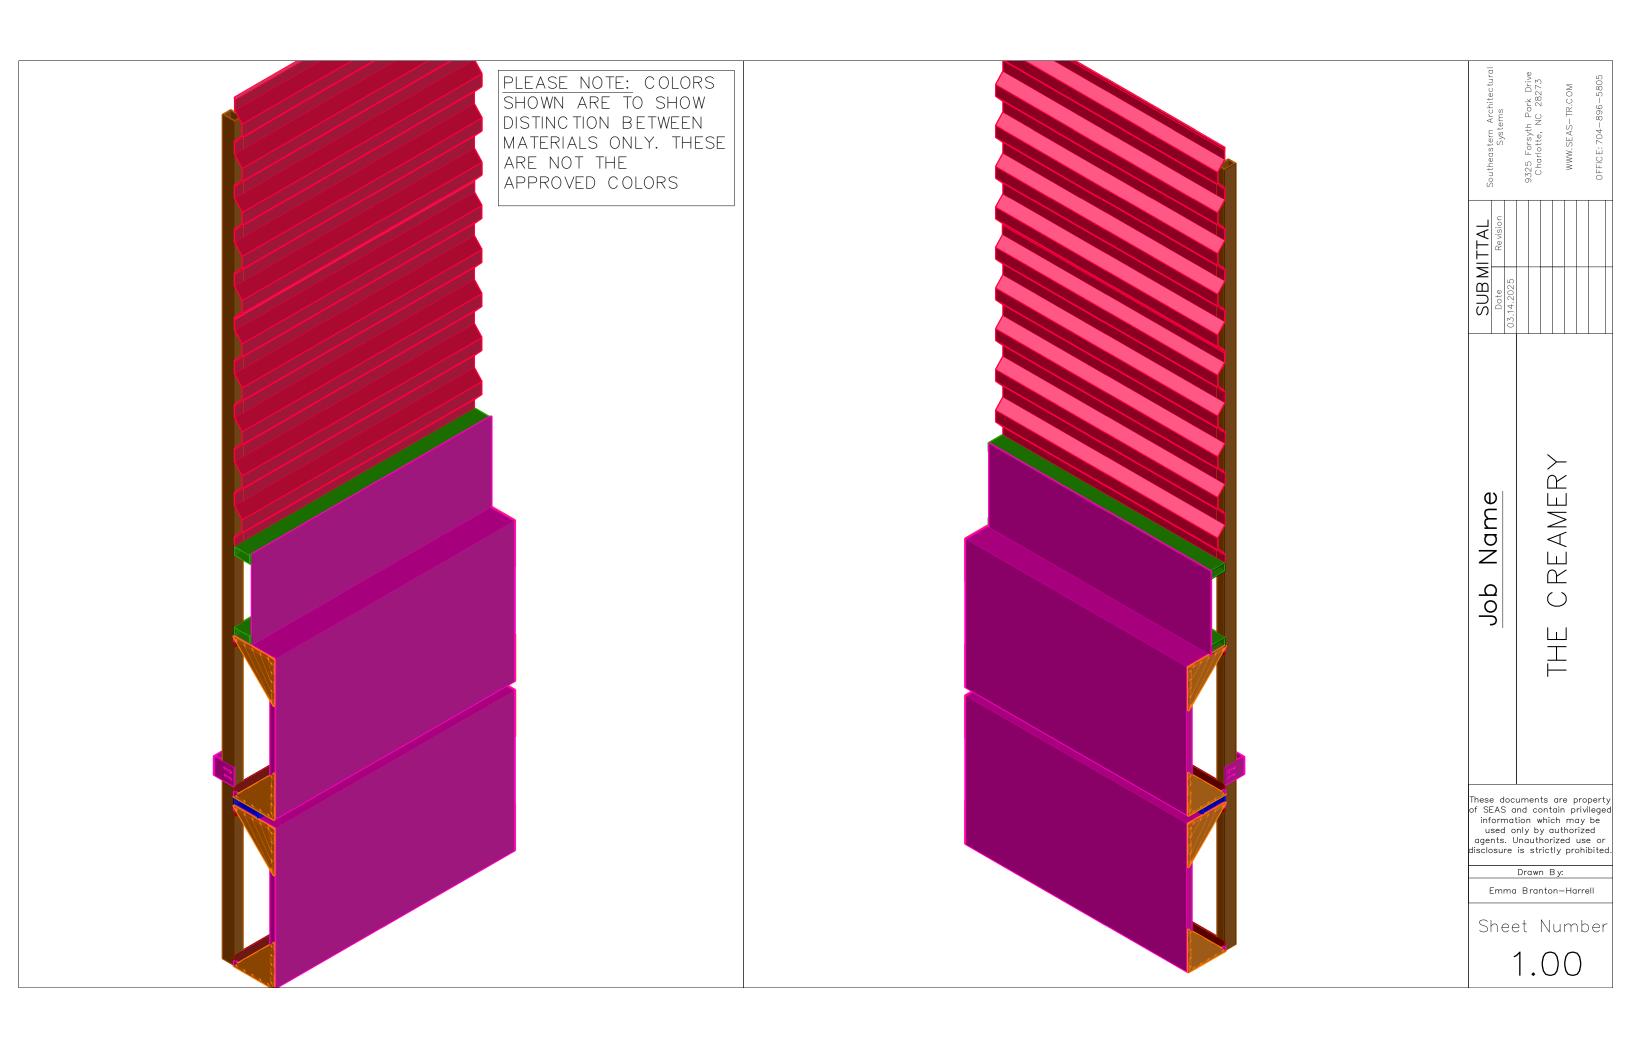

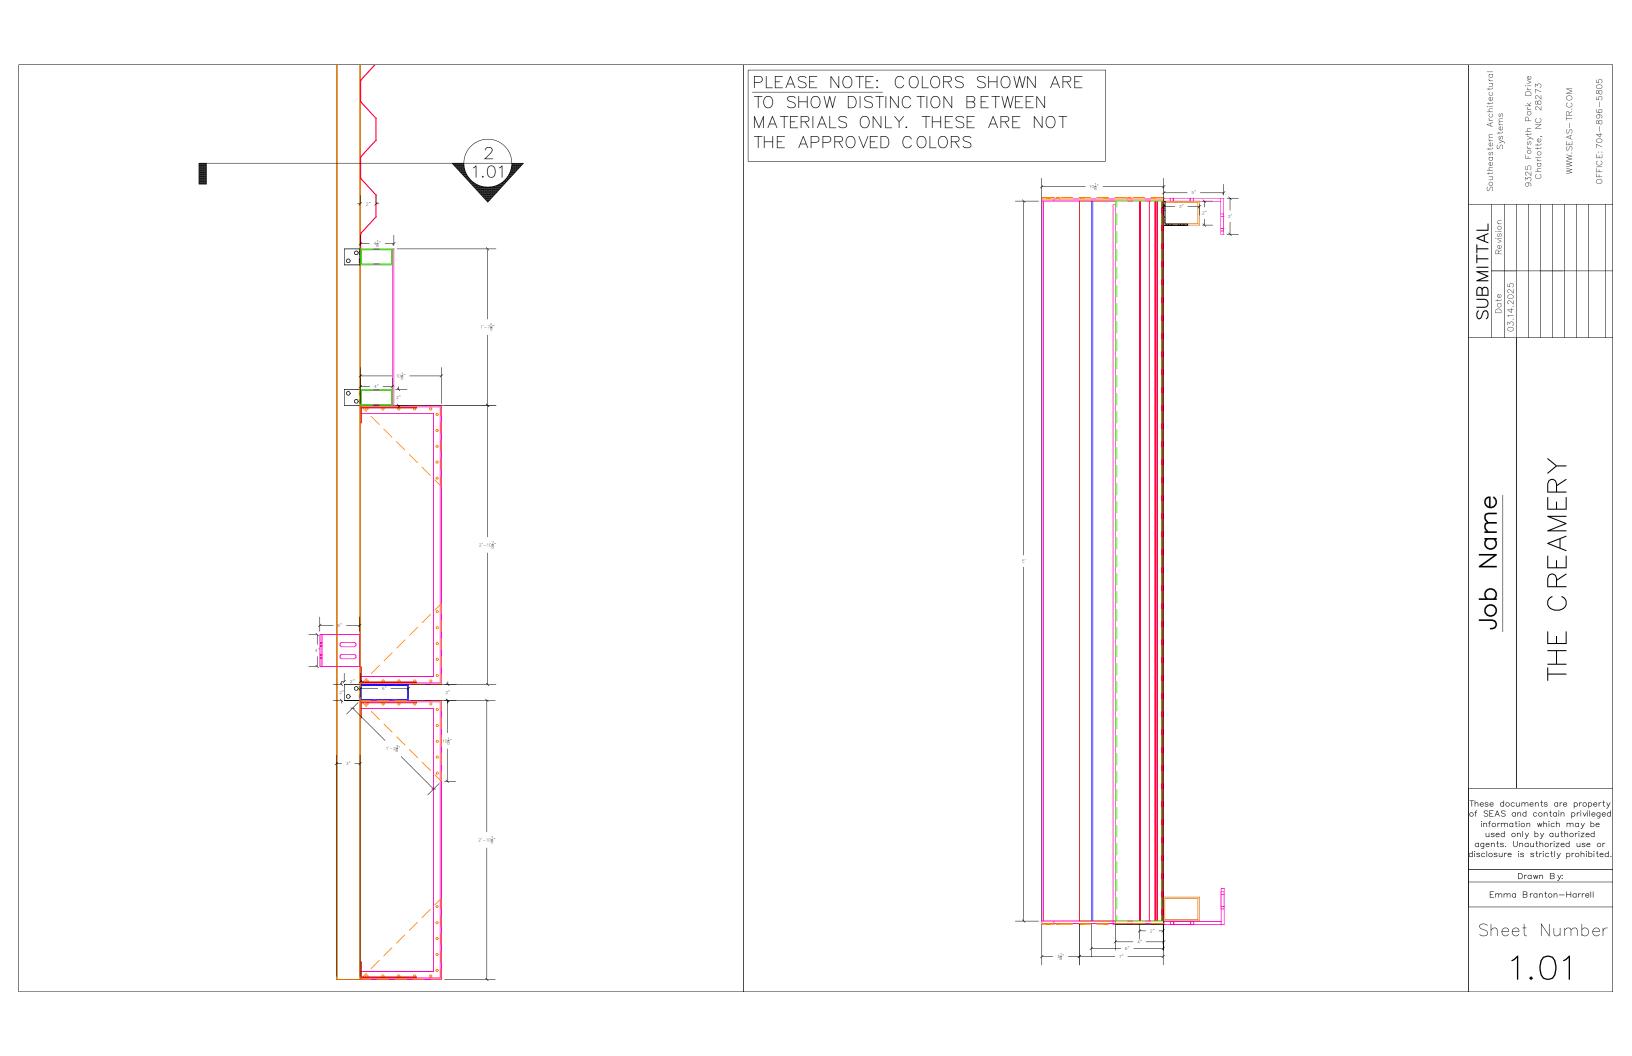

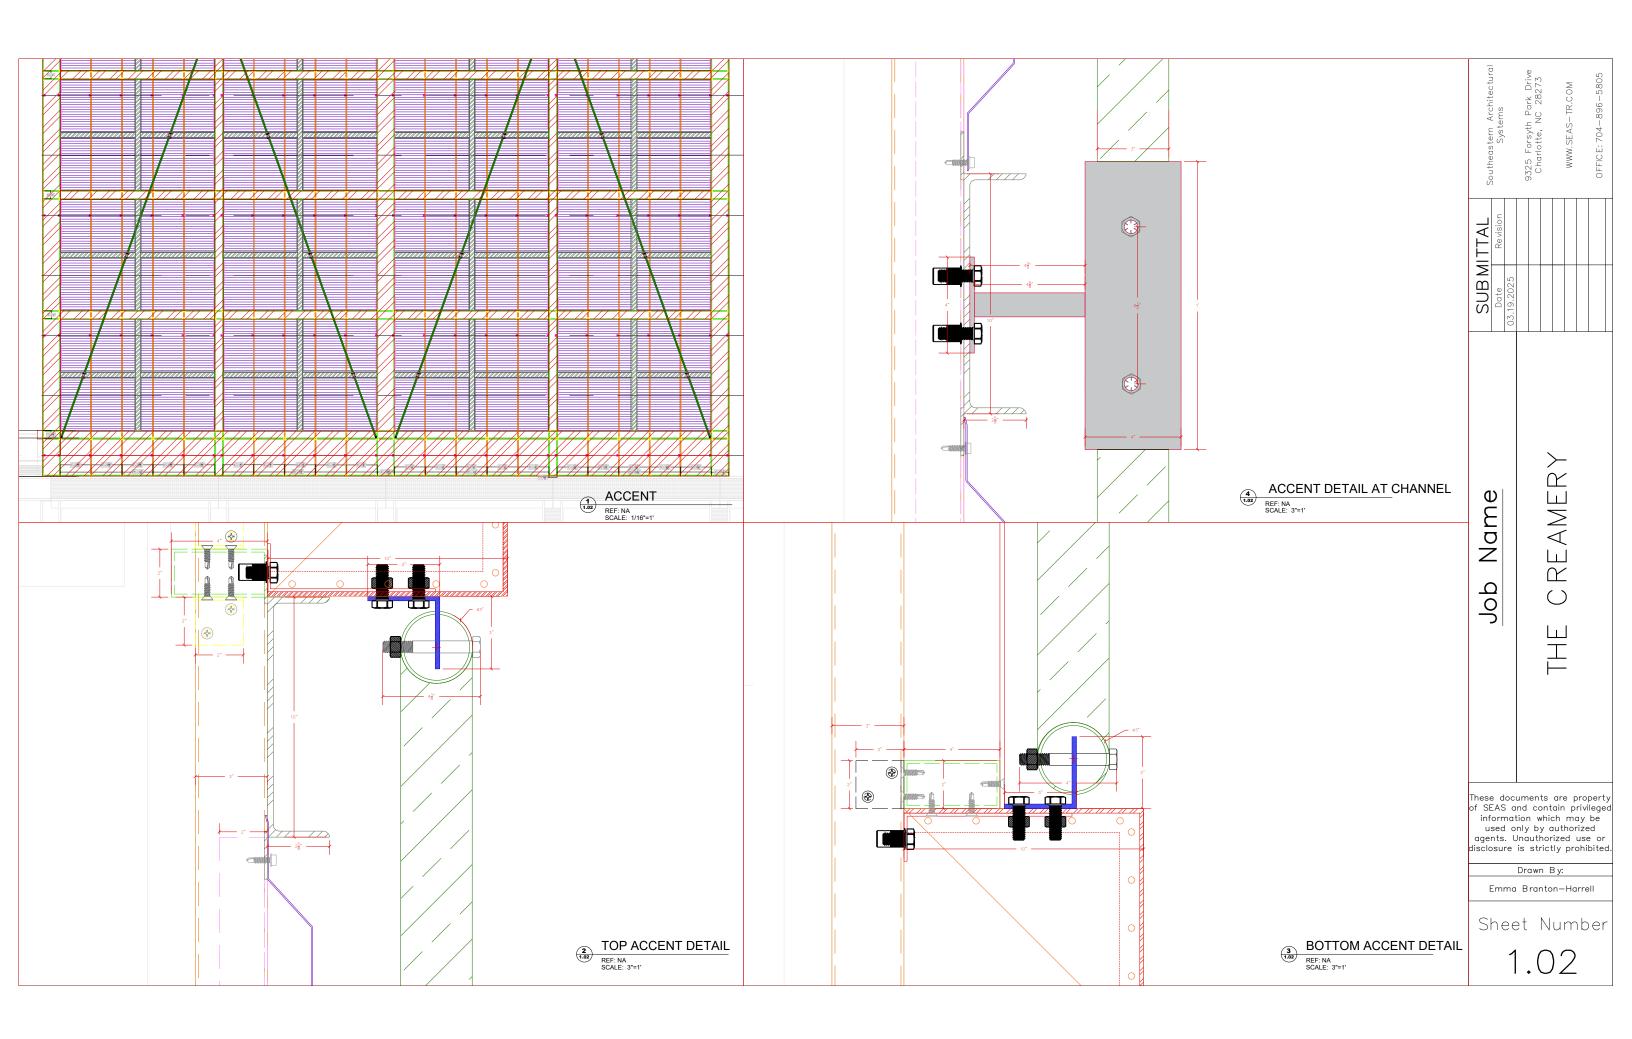

#### Material/Detail Modifications at the Galleria

#### Summary of street level storefront rearrangements at the galleria:

- 1. To fit the revised ramp for the phased construction (which also eliminates the sloped parking floors in the previously-approved COA), the retail spaces in the galleria have been eliminated due to reduced ceiling heights and are now replaced with service and utility spaces beneath the ramp.
- 3. The brick and concrete frame and the five associated storefront bay sizes have been slightly adjusted to fit the revised structural grid for the parking deck ramp but remain generally consistent with the previously-approved COA.
- 4. With the retail removed, the storefronts in these five bays have been replaced with brick infill with man doors, overhead doors, and a mechanical louver to provide access to the building service areas under the ramp. The brick infill will match the brick used at the North Street elevation. The overall composition is generally consistent with the service elevation at the 1997 rear addition to the historic Creamery building.

#### Summary of galleria ceiling revisions:


- 1. Based on the garage changes, the profiled ceiling in the galleria has been simplified to a flat ceiling.
  - The precast ceiling has been changed to synthetic stucco and will be painted to be similar color and texture to the precast elements on the building.

#### Documentary materials and samples:

- 1. Side-by-side rendered elevations for the previously-approved and currently proposed elevation illustrates these modifications.
- 2. Architectural drawing 4/A3.73 illustrates the Galleria elevation. Door schedule A11.02 confirms door sizes per Condition #4 of the December 09, 2021 Decision Letter.
- 3. Architectural drawings 2 and 3/A8.52 illustrate this wall and ceiling sections through the Galleria. Note that 5 and 6/A8.52 (cut through the opposite residential building wall) show the continuation of the ceiling.
- 4. A graphic material key shows material colors and selections for the building. *Material samples and colors will be delivered to the RHDC office.*



#### **ELEVATION FROM APPROVED RHDC SUBMISSION**

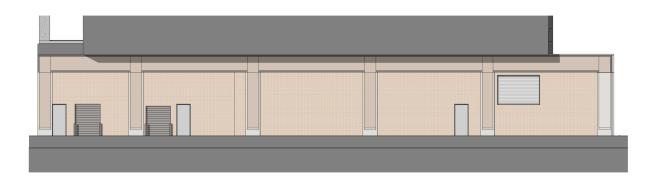

PROPOSED ELEVATION

## Galleria Elevation

DOOR SCHEDULE - COMMON DOORS						EDULE - COMMON DOOR	S		DOOR SCHEDULE - COMMON DOORS									
SIZE CONSTRUCTION				SIZE		CON	ISTRUCTION					SIZE			CONSTRUC	CTION		
Mark ELEV WIDTH HEIGHT THICKNESS FIRE RATING PANEL FRAME HARDWARE Location	n Comments	Mark ELE	WIDTH H	HEIGHT TI	HICKNESS FIRE RA		L FRAME HARDW	ARE Location	Comments	Mark E	ELEV WIDT	TH HEIGHT	THICKNES	S FIRE RATING	PANEL F	RAME I	HARDWARE Location	Comments
LEVEL 00 BASEMENT  1848 A 3' - 0" 7' - 4" 1 3/4" 0 WD WD		518 A 555 A	3' - 0" /' -	- 4"   1 3 - 4"   1 3	3/4" 0 3/4" 0	WD WD	WD WD			809 A 810 A	3' - 0"	7' - 4" 7' - 0"	1 3/4"	20 MIN	HM HM	1	TENANT STORAGE	
LEVEL 01@W NORTH ST		556 A	3' - 0" 7' -	- 4"	3/4" 0	WD	WD			G801A E	5' - 0"	7' - 4"	1 3/4"	0	HM HM	1	POOL EQUIPMENT	
104 D 3' - 0" 7' - 6" 1 1/2" 0 AL AL BFP		947 A	3' - 0" 7' -	- 4" 13	3/4" 0	WD	WD			G801B E	6' - 0"	7' - 4"	1 3/4"	90 MIN	HM HM	1	POOL CHEMICAL STORAGE	
107A   A   3' - 0"   7' - 4"   1 3/4"   5   90 MIN / 180 MIN HM   HM   LOADING CORRIDOR   110   A   3' - 0"   7' - 4"   1 3/4"   90 MIN / 180 MIN WD   MTL   ELEV. CONTROL RM		1130 A 1134 A	3' - 0" 7' - 3' - 0" 7' -	- 4 1 3 - 4" 1 3	3/4" 0	WD WD	WD			G802 A SA-8A A	3 - 0"	7' - 0"	1 3/4"	45 MIN	HM HM	1	DECK ELECTRICAL STAIR A	PANIC HARDWARE
E-001.1 D 3' - 0" 7' - 6" 1 1/2" 0 AL AL GARAGE - TRANSFORM	IER	1135 A	3' - 0" 7' -	- 4" 13	3/4" 0	WD	WD			SA-8B A	3' - 0"	7' - 4"	1 3/4"	90 MIN	HM HM	1	STAIR A	PANIC HARDWARE
E-001.2 H 10' - 0" 10' - 0" 3" STL STL GARAGE - TRANSFORM	1ER	SA-3A A	3' - 0" 7' -	- 4" 13	3/4" 45 MIN	HM	HM	STAIR A	PANIC HARDWARE	SB-8 A	3' - 0"	7' - 4"	1 3/4"	90 MIN	HM HM	1	STAIR B	PANIC HARDWARE
E-002.1 D 3' - 0" 7' - 6" 1 1/2" 0 AL AL AL	ATOR PANIC HARDWARE	SA-3B A	3' - 0" 7' -	- 4" 1 3 - 4" 1 3	3/4" 90 MIN	HM	HM	STAIR A STAIR B	PANIC HARDWARE PANIC HARDWARE	SG8B A	3' - 0"	7' - 4"	1 3/4"	90 MIN 90 MIN	HM HM	/I /I	STAIR C STAIR C	PANIC HARDWARE PANIC HARDWARE
E-003.1 A 3' - 0" 7' - 4" 1 3/4" 90 MIN HM HM GARAGE - RETAIL/RES		SG-4 A	3' - 0" 7' -	- 4" 13	3/4" 90 MIN	HM	HM	STAIR C	PANIC HARDWARE	LEVEL 09			1 0/ 1	00 1/1111			O I A II	17441017418177412
E-003.2 H 6' - 0" 8' - 0" 3" 5 0 STL STL GARAGE - RETAIL/REST	T TRASH	LEVEL 04	01 011	411	0/41	110.4		FIDE OFFICION LODDY	DANIO HADDIMADE	900A E	6' - 0"	7' - 4"	1 3/4"	45 MIN	HM HM	1	FIRE SERVICE LOBBY	
E-004 E 6' - 0" 8' - 0" 1 3/4" { 0 } HM HM GARAGE - STORAGE  E-005.1 A 3' - 0" 7' - 4" 1 3/4" 90 MIN HM HM GARAGE - LOADING CO	PRRIDOR	400A E 400B E	6' - 0"	- 4" 1 3 - Δ" 1 3	3/4" 45 MIN 3/4" 45 MIN	HM	HM HM	FIRE SERVICE LOBBY FIRE SERVICE LOBBY	PANIC HARDWARE PANIC HARDWARE	900B E 902 A	6' - 0" 3' - 0"	/' - 4" 7' - Δ"	1 3/4"	45 MIN 90 MIN	HM HM	/I /I	FIRE SERVICE LOBBY ELEC	
E-005.2 H 6' - 0" 7' - 0" 3" 0 STL STL LOADING CORRIDOR	THUBOIT	402 A	3' - 0" 7' -	- 4"	3/4" 90 MIN	HM	HM	ELEC	17 WO TH WENT WE	903 A	3' - 0"	7' - 4"	1 3/4"	45 MIN	HM HM	1	BDA/FIRE/TEL	
E-006.1 A 3' - 0" 7' - 4" 1 3/4" 90 MIN HM HM GARAGE - RESI TRASH		403 A	3' - 0" 7' -	- 4" 13	3/4" 90 MIN	HM	HM	BDA/FIRE/TEL		904 A	3' - 0"	7' - 4"	1 3/4"	90 MIN	HM HM	1	MECH	
E-006.2 A 3' - 0" 7' - 4" 1 3/4" 90 MIN HM HM GARAGE - RESI TRASH E-006.3 H 6' - 0" 7' - 6" 3" 0 STL STL GARAGE - RESI TRASH		404 A 407 A	3' - 0" 7' - 3' - 0" 7' -	- 4"	3/4" 90 MIN 3/4" 45 MIN	HM HM	HM HM	MECH		907A A	3' - 0"	7' - 4"	1 3/4"	45 MIN 0	HM HM	/I /I	TRASH TENANT STORAGE & PRV	
E-006.4 H 6' - 0" 8' - 0" 3" 0 STL STL GARAGE - RESI TRASH		408A A	3' - 0" 7' -	- 4" 13	3/4" 20 MIN	HM	HM	ENTRY VESTIBULE		5 909 A	3-0"	7'-4"	13/4"		WD WD		TENANT STORAGE & PRV STORMECH RESERVABLE ROOM	
E-106 D 3' - 0" 8' - 0" 1 1/2" 0 AL AL EXIT PASSAGEWAY	PANIC HARDWARE	408B D	3' - 0" 7' -	- 8" 1 1	1/2" 0	GL	AL	ENTRY VESTIBULE		912A E	6' - 0"	10' - 0"	1 3/4"				RESERVABLE ROOM	
E-107A H 6' - 0" 8' - 0" 3" 0 STL STL RESI TRASH E-107B A 3' - 0" 7' - 4" 1 3/4" 90 MIN HM HM		409 E 410 A	6' - 0" 7' - 3' - 0" 7' -	- U"   1 3 - O"   1 3	3/4" 0 3/4" 0	HM HM	HM HM	MAINTENANCE OFFICE		912B   A	5' - 11"	8' - 0"	2"		AL AL		RESERVABLE ROOM	SEE INT ELEVS, PANIC HARDWARE
E-107B A 3' - 0" 7' - 4" 1 3/4" 90 MIN HM HM		SA-4A A	3' - 0" 7' -	- 4" 13	3/4" 45 MIN	HM	HM	STAIR A	PANIC HARDWARE	913 A	3' - 0"	7' - 4"	1 3/4"	20 MIN	WD MT	L	MENS WC	
E-109 B 3' - 0" 7' - 4" 1 3/4" 90 MIN HM HM		SA-4B A	3' - 0" 7' -	- 4" 13	3/4" 90 MIN	НМ	HM	STAIR A	PANIC HARDWARE	914 A	3' - 0"	7' - 4"	1 3/4"	20 MIN	WD MT	L	WOMENS WC	
E-121.1 A 3' - 0" 7' - 4" 1 3/4" 90 MIN HM HM HM		SB-4 A	3' - 0" 7' -	- 4"   13	3/4" 90 MIN	HM	HM	STAIR B	PANIC HARDWARE	917A A E-913 D	3' - 0" 3' <sub>-</sub> 0"	/' - 4" 8' - 0"	1 3/4"	20 MIN 0	VVU MT	L	CHANGING ROOM SUMMER KITCHEN	PANIC HARDWARE
E-121.2 A 6' - 0 1/2" 8' - 0 1/4" 2" 0 AL AL RETAIL 2 E-121.3 A 6' - 0 1/2" 8' - 0 1/4" 2" 0 AL AL RETAIL 2	PANIC HARDWARE PANIC HARDWARE	SG-5 A	J - U / / -	- 4   13	3/4" 90 MIN	HM	IIIVI	STAIR C	PANIC HARDWARE	E-913 D	6' - 0"	8' - 0"	2"	0	AL AL		SUMMER KITCHEN	PANIC HARDWARE
E-121.5 A 6' - 0" 8' - 0" 2" 0 AL AL RETAIL 2	PANIC HARDWARE	500A E	6' - 0" 7' -	- 4" 13		НМ	HM	FIRE SERVICE LOBBY	PANIC HARDWARE	SA-9A A	3' - 0"	7' - 4"	1 3/4"	90 MIN	HM HM	1	STAIR A	PANIC HARDWARE
E-122.2 A 6' - 0 1/2" 8' - 0 1/4" 2" 0 AL AL RETAIL 2	PANIC HARDWARE	500B E	6' - 0" 7' -	- 4" 13	3/4" 45 MIN	HM	HM	FIRE SERVICE LOBBY	PANIC HARDWARE	SA-9B A SB-9 A	3' - 0"	7' - 4"	1 3/4"	90 MIN	HM HM	1	STAIR A STAIR B	PANIC HARDWARE
E-122.3 A 6' - 0 1/2" 8' - 0 1/4" 2" 0 AL AL RETAIL 2 E-155.1 A 6' - 0" 8' - 0" 2" 0 AL AL RETAIL 3	PANIC HARDWARE PANIC HARDWARE	502 A 503 Δ	3' - 0" 7' - 3' - 0" 7' -	- 4"   13 - 4"   13	3/4" 90 MIN 3/4" 90 MIN	HM HM	HM	BDA/FIRE/TEL		RESI LEVEL	10	/· - 4··	1 3/4"	90 MIN	ı iivi   MIVI	п	DIAIRD	PANIC HARDWARE
E-155.2 A 6' - 0" 8' - 0" 2" 0 AL AL RETAIL 3	PANIC HARDWARE	504 A	3' - 0" 7' -	- 4"	3/4" 90 MIN	HM	HM	MECH		1000A E	6' - 0"	7' - 4"	1 3/4"	45 MIN	HM HM	1	FIRE SERVICE LOBBY	PANIC HARDWARE
E-SG-1 D 3' - 0" 7' - 6" 1 1/2" 0 AL AL GARAGE - STAIR	PANIC HARDWARE	507 A	3' - 0" 7' -	- 4" 13	3/4" 45 MIN	HM	HM	TRASH		1000B E	6' - 0"	7' - 4"	1 3/4"	45 MIN	HM HM	1	FIRE SERVICE LOBBY	PANIC HARDWARE
SB-1   A   3' - 0"   7' - 4"   1 3/4"   90 MIN   HM   HM   STAIR B   LEVEL 01@RESI LOBBY	PANIC HARDWARE	508A A 508B D	3' - 0" 7' -	- 4" 13	3/4" 20 MIN	HM	HM	ENTRY VESTIBULE ENTRY VESTIBULE		1002 A 1003 A	3' - 0"	/' - 4" 7' - Δ"	1 3/4"	90 MIN 90 MIN	HM HM	/I /I	BDA/FIRE/TEL	
102 A 4' - 0" 8' - 0" 1 3/4" 0 HM HM CORE - ELECTRIC & FIF	RE/BDA/TEL& PANIC HARDWARE	500B D	3' - 0" 7' -	- 0 1 - 4" 1 3	3/4" 20 MIN	HM	HM	TENANT STORAGE		1004 A	3' - 0"	7' - 4"	1 3/4"	90 MIN	HM HM	1	MECH	
STAIR A		510 A	3' - 0" 7' -	- 0" 13	3/4" 0	НМ	HM	DRY SPR		1007 A	3' - 0"	7' - 4"	1 3/4"	45 MIN	HM HM	1	TRASH	
105 A 3' - 0" 7' - 4" 1 3/4" 90 MIN HM HM FIRE COMMAND		1210 A	3' - 0" 7' -	- 0" 13	3/4" 0	НМ	HM			SA-10A A	3' - 0"	7' - 4"	1 3/4"	45 MIN	HM HM	1	STAIR A	PANIC HARDWARE
111   A   5' - 9 1/2"   8' - 11 9/32"   2"   0   AL   AL   LOBBY VESTIBULE   113   A   3' - 0"   7' - 4"   1 3/4"   0   WD   HM   PACKAGE ROOM	PANIC HARDWARE	SA-5A A SA-5B A	3' - 0" 7' -	- 4"   1 3 - 4"   1 3	3/4" 45 MIN 3/4" 90 MIN	HM	HM	STAIR A STAIR A	PANIC HARDWARE PANIC HARDWARE	SA-10B A SB-10 A	3' - 0"	7 - 4	1 3/4"	90 MIN 90 MIN	HM HM	1	STAIR A STAIR B	PANIC HARDWARE PANIC HARDWARE
114A A 3' - 0" 7' - 4" 1 3/4" 20 MIN WD MTL STORAGE		SB-5 A	3' - 0" 7' -	- 4"	3/4" 90 MIN	HM	HM	STAIR B	PANIC HARDWARE	RESI LEVEL	11		1 0/ 1		1			
114B A 3' - 0" 7' - 4" 1 3/4" 20 MIN WD MTL STORAGE		SG-6 A	3' - 0" 7' -	- 4" 13	3/4" 90 MIN	НМ	НМ	STAIR C	PANIC HARDWARE	1100A E	6' - 0"	7' - 4"	1 3/4"	45 MIN	HM HM	1	FIRE SERVICE LOBBY	PANIC HARDWARE
117   A   3' - 0"   8' - 0"   1 3/4"   0   WD   HM   LEASING PANTRY   119   D   3' - 0"   7' - 10"   1 1/2"   0   GL   AL   LEASING OFFICE 1	SEE INT ELEVS	LEVEL 06	CI OII 71	411 4 6	2/4" 45 MINI	1.15.4	LINA	FIDE CEDVICE LODDY	DANIIO HADDIMADE	1100B E 1102 A	6' - 0" 3' - 0"	7' - 4" 7' - 4"	1 3/4"	45 MIN 90 MIN	HM HM	Λ   Λ	FIRE SERVICE LOBBY ELEC	PANIC HARDWARE
120 D 3' - 0" 7' - 10" 1 1/2" 0 GL AL LEASING OFFICE 2	SEE INT ELEVS	600A E 600B E	6' - 0" 7' -	- 4" 1 3 - 4" 1 3	3/4" 45 MIN	НМ	HM	FIRE SERVICE LOBBY FIRE SERVICE LOBBY	PANIC HARDWARE PANIC HARDWARE	1102 A	3' - 0"	7' - 4"	1 3/4"	90 MIN	HM HM	1	BDA/FIRE/TEL	
SA-1A A 3' - 0" 8' - 0" 1 3/4" 90 MIN HM HM CORE - ELECTRIC & FIF	RE/BDA/TEL& PANIC HARDWARE	602 A	3' - 0" 7' -	- 4" 13	3/4" 90 MIN		HM	ELEC		1104 A	3' - 0"	7' - 4"	1 3/4"	90 MIN	HM HM	1	MECH	
LEVEL 01 FINISH		603 A	3' - 0" 7' -	- 4" 13	3/4" 90 MIN	HM	HM	BDA/FIRE/TEL		1107 A	3' - 0"	7' - 4"	1 3/4"	45 MIN	HM HM	1	TRASH STAIR A	PANIC HARDWARE
E-111 A 6' - 0" 9' - 0" 2" 0 AL AL LOBBY VESTIBULE	PANIC HARDWARE	604 A	3' - 0" 7' -	- 4"   1 3 - Δ"   1 3	3/4" 90 MIN 3/4" 45 MIN	HM HM	HM HM	MECH TRASH		SA-11A A SA-11B A	3' - 0"	7 - 4	1 3/4"	45 MIN 90 MIN	HM HM	1	STAIR A	PANIC HARDWARE
LOBBY FFE	1.	608A A	3' - 0" 7' -	- 4"	3/4" 20 MIN	HM	HM	ENTRY VESTIBULE		SB-11 A	3' - 0"	7' - 4"	1 3/4"	90 MIN	HM HM	1	STAIR B	PANIC HARDWARE
115   D   3' - 0"   8' - 0"   1 1/2"   0   GL   AL   LEASING LOBBY   116   A   3' - 0"   7' - 4"   1 3/4"   0   WD   WD   PUBLIC RESTROOM	SEE INT ELEVS	608B D	3' - 0" 7' -	- 8" 1 1	1/2" 0	GL	AL	ENTRY VESTIBULE		RESI LEVEL	12	71 411	4.0/4!!	45 MINI	1.15.4	4	FIDE CEDVICE LODDY	DANIC HADDWADE
SA-1B A 3' - 0" 8' - 0" 1 3/4" 90 MIN HM HM CORE - ELECTRIC & FIF	RE/BDA/TEL& PANIC HARDWARE	609 A	3' - 0" 7' -	- 4"   13   0"   13	3/4" 20 MIN	HM	HM	TENANT STORAGE DRY SPR		1200A E 1200B E	6' - 0"	7' - 4"	1 3/4"	45 MIN 45 MIN	HM HM	/I /I	FIRE SERVICE LOBBY FIRE SERVICE LOBBY	PANIC HARDWARE PANIC HARDWARE
STAIR A		SA-6A A	3' - 0" 7' -	- 0 1 3 - 4" 1 3	3/4" U 45 MIN	HM	HM	STAIR A	PANIC HARDWARE	1200B L	3' - 0"	7' - 4"	1 3/4"	90 MIN	HM HM	1	ELEC	
LEVEL 1.5  152 A 3' - 0" 7' - 4" 1 3/4" 90 MIN HM HM EMERGENCY ELEC		SA-6B A	3' - 0" 7' -	- 4" 13	3/4" 90 MIN	НМ	НМ	STAIR A	PANIC HARDWARE	1203 A	3' - 0"	7' - 4"	1 3/4"	90 MIN	HM HM	1	BDA/FIRE/TEL	
152 A 3 - 0 7 - 4 1 3/4 90 MIN HM HM EMERGENCY ELEC		SB-6 A	3' - 0" 7' -	- 4" 13	3/4" 90 MIN	HM	HM	STAIR B	PANIC HARDWARE	1204 A 1207A A	3' - 0"	7' - 4"	1 3/4"	90 MIN 45 MIN	HM HM	/I	MECH TRASH	
154 E 6' - 0" 8' - 0" 1 3/4" 90 MIN HM HM RESI & RETAIL MAIN EL		SG-7 A LEVEL 07	3° - U"   7' -	· 4"  13	3/4" 90 MIN	HM	HIVI	STAIR C	PANIC HARDWARE	1207A A	3' - 0"	7' - 4"	1 3/4"	0	HM HM	1	TENANT STORAGE & PRV	
SB1.5 A 3' - 0" 7' - 4" 1 3/4" 90 MIN HM HM STAIR B	PANIC HARDWARE	700A E	6' - 0" 7' -	- 4" 13	3/4" 45 MIN	НМ	НМ	FIRE SERVICE LOBBY	PANIC HARDWARE	SA-12A A	3' - 0"	7' - 4"	1 3/4"	45 MIN	HM HM	1	STAIR A	PANIC HARDWARE
LEVEL 02    200A   E   6' - 0"   7' - 4"   1 3/4"   45 MIN   HM   HM   FIRE SERVICE LOBBY	PANIC HARDWARE	700B E	6' - 0" 7' -	- 4" 13	3/4" 45 MIN	HM	HM	FIRE SERVICE LOBBY	PANIC HARDWARE	SA-12B A	3' - 0"	7' - 4"	1 3/4"	90 MIN	HM HM	1	STAIR A	PANIC HARDWARE
200B E 6' - 0" 7' - 4" 1 3/4" 45 MIN HM HM FIRE SERVICE LOBBY	PANIC HARDWARE	702 A	3' - 0" 7' - 3' - 0" 7' -	- 4"   1 3 - 4"   1 3	3/4" 90 MIN	HM HM	HM HM	ELEC BDA/FIRE/TEL		SB-12 A	13 - U"	/' - 4"	1 3/4"	90 MIN	□IVI   HIVI	п	STAIR B	PANIC HARDWARE
202 A 3' - 0" 7' - 4" 1 3/4" 90 MIN HM HM ELEC		703 A 704 A	3' - 0" 7' -	- 4" 13	3/4" 90 MIN	HM	HM	MECH		1300A E	6' - 0"	7' - 4"	1 3/4"	45 MIN	HM HM	1	FIRE SERVICE LOBBY	PANIC HARDWARE
203   A   3' - 0"   7' - 4"   1 3/4"   90 MIN   HM   HM   BDA/FIRE/TEL		707 A	3' - 0" 7' -	- 4" 13	3/4" 45 MIN	НМ	НМ	TRASH		1300B E	6' - 0"	7' - 4"	1 3/4"	45 MIN	HM HM	1	FIRE SERVICE LOBBY	PANIC HARDWARE
207A A 3' - 0" 7' - 4" 1 3/4" 45 MIN HM HM TRASH		708A A	3' - 0" 7' -	- 4"   13	3/4" 20 MIN	HM	HM	ENTRY VESTIBULE		1302 A 1303 A	3' - 0" 3' - 0"	7' - 4" 7' - 4"	1 3/4"	90 MIN 90 MIN	HM HM	/I	BDA/FIRE/TEL	
207B A 3' - 0" 7' - 4" 1 3/4" 0 HM HM TENANT STORAGE & PI		708B D 709 A	3' - 0" 7' -	- o   1 1 - 4"   1 3	3/4" U 20 MIN	GL HM	HM	ENTRY VESTIBULE TENANT STORAGE		1303 A	3' - 0"	7 - 4	1 3/4"	90 MIN	HM HM	1	MECH	
208A A 3' - 0" 7' - 4" 1 3/4" 20 MIN HM HM ENTRY VESTIBULE & BI	KE STORAGE	710 A	3' - 0" 7' -	- 0" 13	3/4" 0	HM	HM	DRY SPR		1307 A	3' - 0"	7' - 4"	1 3/4"	45 MIN	HM HM	1	TRASH	
208B   D   3' - 0"   7' - 8"   1 1/2"   0   GL   AL   ENTRY VESTIBULE   209   A   3' - 0"   7' - 4"   1 3/4"   20 MIN   HM   HM   ENTRY VESTIBULE & BI	KE STORAGE	SA-7A A	3' - 0" 7' -	- 4" 13	3/4" 45 MIN	HM	HM	STAIR A	PANIC HARDWARE	SA-13A A	3' - 0"	7' - 4"	1 3/4"	45 MIN	HM HM	1	STAIR A	PANIC HARDWARE
210 A 3' - 0" 7' - 0" 1 3/4" 0 HM HM DRY SPR		SA-7B A SB-7 A	3' - 0" 7' - 3' - 0" 7' -	- 4"   1 3 - 4"   1 3	3/4" 90 MIN	HM	HM HM	STAIR A STAIR B	PANIC HARDWARE PANIC HARDWARE	SA-13B A SB-13 A	3' - 0" 3' - 0"	7' - 4"	1 3/4"	90 MIN 90 MIN	HM HM	1	STAIR A STAIR B	PANIC HARDWARE PANIC HARDWARE
G201 A 3' - 0" 7' - 4" 1 3/4" 90 MIN HM HM STAIR PRESSURIZATIO	N FAN	SG-8 A	3' - 0" 7' -	- <del>   13</del> - 4"   13	3/4" 90 MIN	HM	HM	STAIR C	PANIC HARDWARE PANIC HARDWARE	RESI LEVEL						·		. ,
G202 A 3' - 0" 7' - 0" 1 3/4" 0 HM HM SA-2A A 3' - 0" 7' - 4" 1 3/4" 45 MIN HM HM STAIR A	PANIC HARDWARE	LEVEL 08								1400A E	6' - 0"	7' - 4"	1 3/4"	45 MIN	HM HM	1	FIRE SERVICE LOBBY	PANIC HARDWARE
SA-2B A 3' - 0" 7' - 4" 1 3/4" 90 MIN HM HM STAIR A	PANIC HARDWARE	800A E		- 4" 1 3			HM	FIRE SERVICE LOBBY	PANIC HARDWARE	1400B E	6' - 0"	7' - 4" 7' - 4"	1 3/4"	45 MIN 90 MIN	HM HM	/I	FIRE SERVICE LOBBY ELEC	PANIC HARDWARE
SB-2 A 3' - 0" 7' - 4" 1 3/4" 90 MIN HM HM STAIR B	PANIC HARDWARE	- 800B E - 802 A	6' - 0" 7' - 3' - 0" 7' -		3/4" 45 MIN 3/4" 90 MIN	HM HM	HM HM	FIRE SERVICE LOBBY ELEC	PANIC HARDWARE	1402 A 1403 A	3' - 0"	7' - 4" 7' - 4"	1 3/4"	90 MIN	HM HM	1	BDA/FIRE/TEL	
SG1.5A A 3' - 0" 7' - 4" 1 3/4" 90 MIN HM HM STAIR C	PANIC HARDWARE	803 A	3' - 0" 7' -		3/4" 90 MIN	HM	HM	BDA/FIRE/TEL		1404 A	3' - 0"	7' - 4"	1 3/4"	90 MIN	HM HM		MECH	
SG1.5B       A       3' - 0"       7' - 4"       1 3/4"       90 MIN       HM       HM       STAIR C         SG-3       A       3' - 0"       7' - 4"       1 3/4"       90 MIN       HM       HM       STAIR C	PANIC HARDWARE PANIC HARDWARE	804 A	3' - 0" 7' -	- 4" 13	3/4" 90 MIN	НМ	HM	MECH		1407A A	3' - 0"	7' - 4"	1 3/4"	45 MIN	HM HM	1	TRASH	
LEVEL 03	I AND HANDWARE	807A A	3' - 0" 7' -	- 4"   13	3/4" 45 MIN	HM	HM	TRASH		1407B A SA-14A A	3' - 0" 3' - 0"	7' - 4" 7' - 4"	1 3/4"	0 45 MIN	HM HM	_	TENANT STORAGE & PRV STAIR A	PANIC HARDWARE
300A E 6' - 0" 7' - 4" 1 3/4" 45 MIN HM HM FIRE SERVICE LOBBY	PANIC HARDWARE	808A A B D	3' - 0" 7' - 3' - 0" 7' -		3/4" 20 MIN 1/2" 0	HM GL	HM AL	ENTRY VESTIBULE ENTRY VESTIBULE		SA-14A A SA-14B A	3' - 0"	7' - 4"	1 3/4"	90 MIN	HM HM		STAIR A STAIR A	PANIC HARDWARE
300B E 6' - 0" 7' - 4" 1 3/4" 45 MIN HM HM FIRE SERVICE LOBBY	PANIC HARDWARE		- •  1 -	- I	<u> </u>	, UL	<u> </u>	, <u></u>			<u> </u>	- I	1	1	, 1 22		·	
302   A   3' - 0"   7' - 4"   1 3/4"   90 MIN   HM   HM   ELEC     303   A   3' - 0"   7' - 4"   1 3/4"   90 MIN   HM   HM   BDA/FIRE/TEL																		  -
304 A 3' - 0" 7' - 4" 1 3/4" 90 MIN HM HM MECH																		

MECH

TRASH

7' - 4"

7' - 4"

3' - 0" 7' - 4" 3' - 0" 7' - 0"

1 3/4" 1 3/4" 1 3/4"

НМ

WIDTH SEE SCHED A J F

COMMON DOOR ELEVATIONS


3/16" = 1'-0"

A11.02

410 GLENWOOD AVENUE PROPERTY LLC

THE CREAMERY - PHASE 1
400-410 Glenwood Avenue
Raleigh, NC 27603




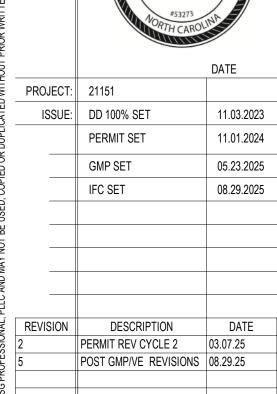

IFC SET REVISION DESCRIPTION DATE

2 PERMIT REV CYCLE 2 03.07.25

5 POST GMP/VE REVISIONS 08.29.25 CONTENT: COMMON DOOR SCHEDULE

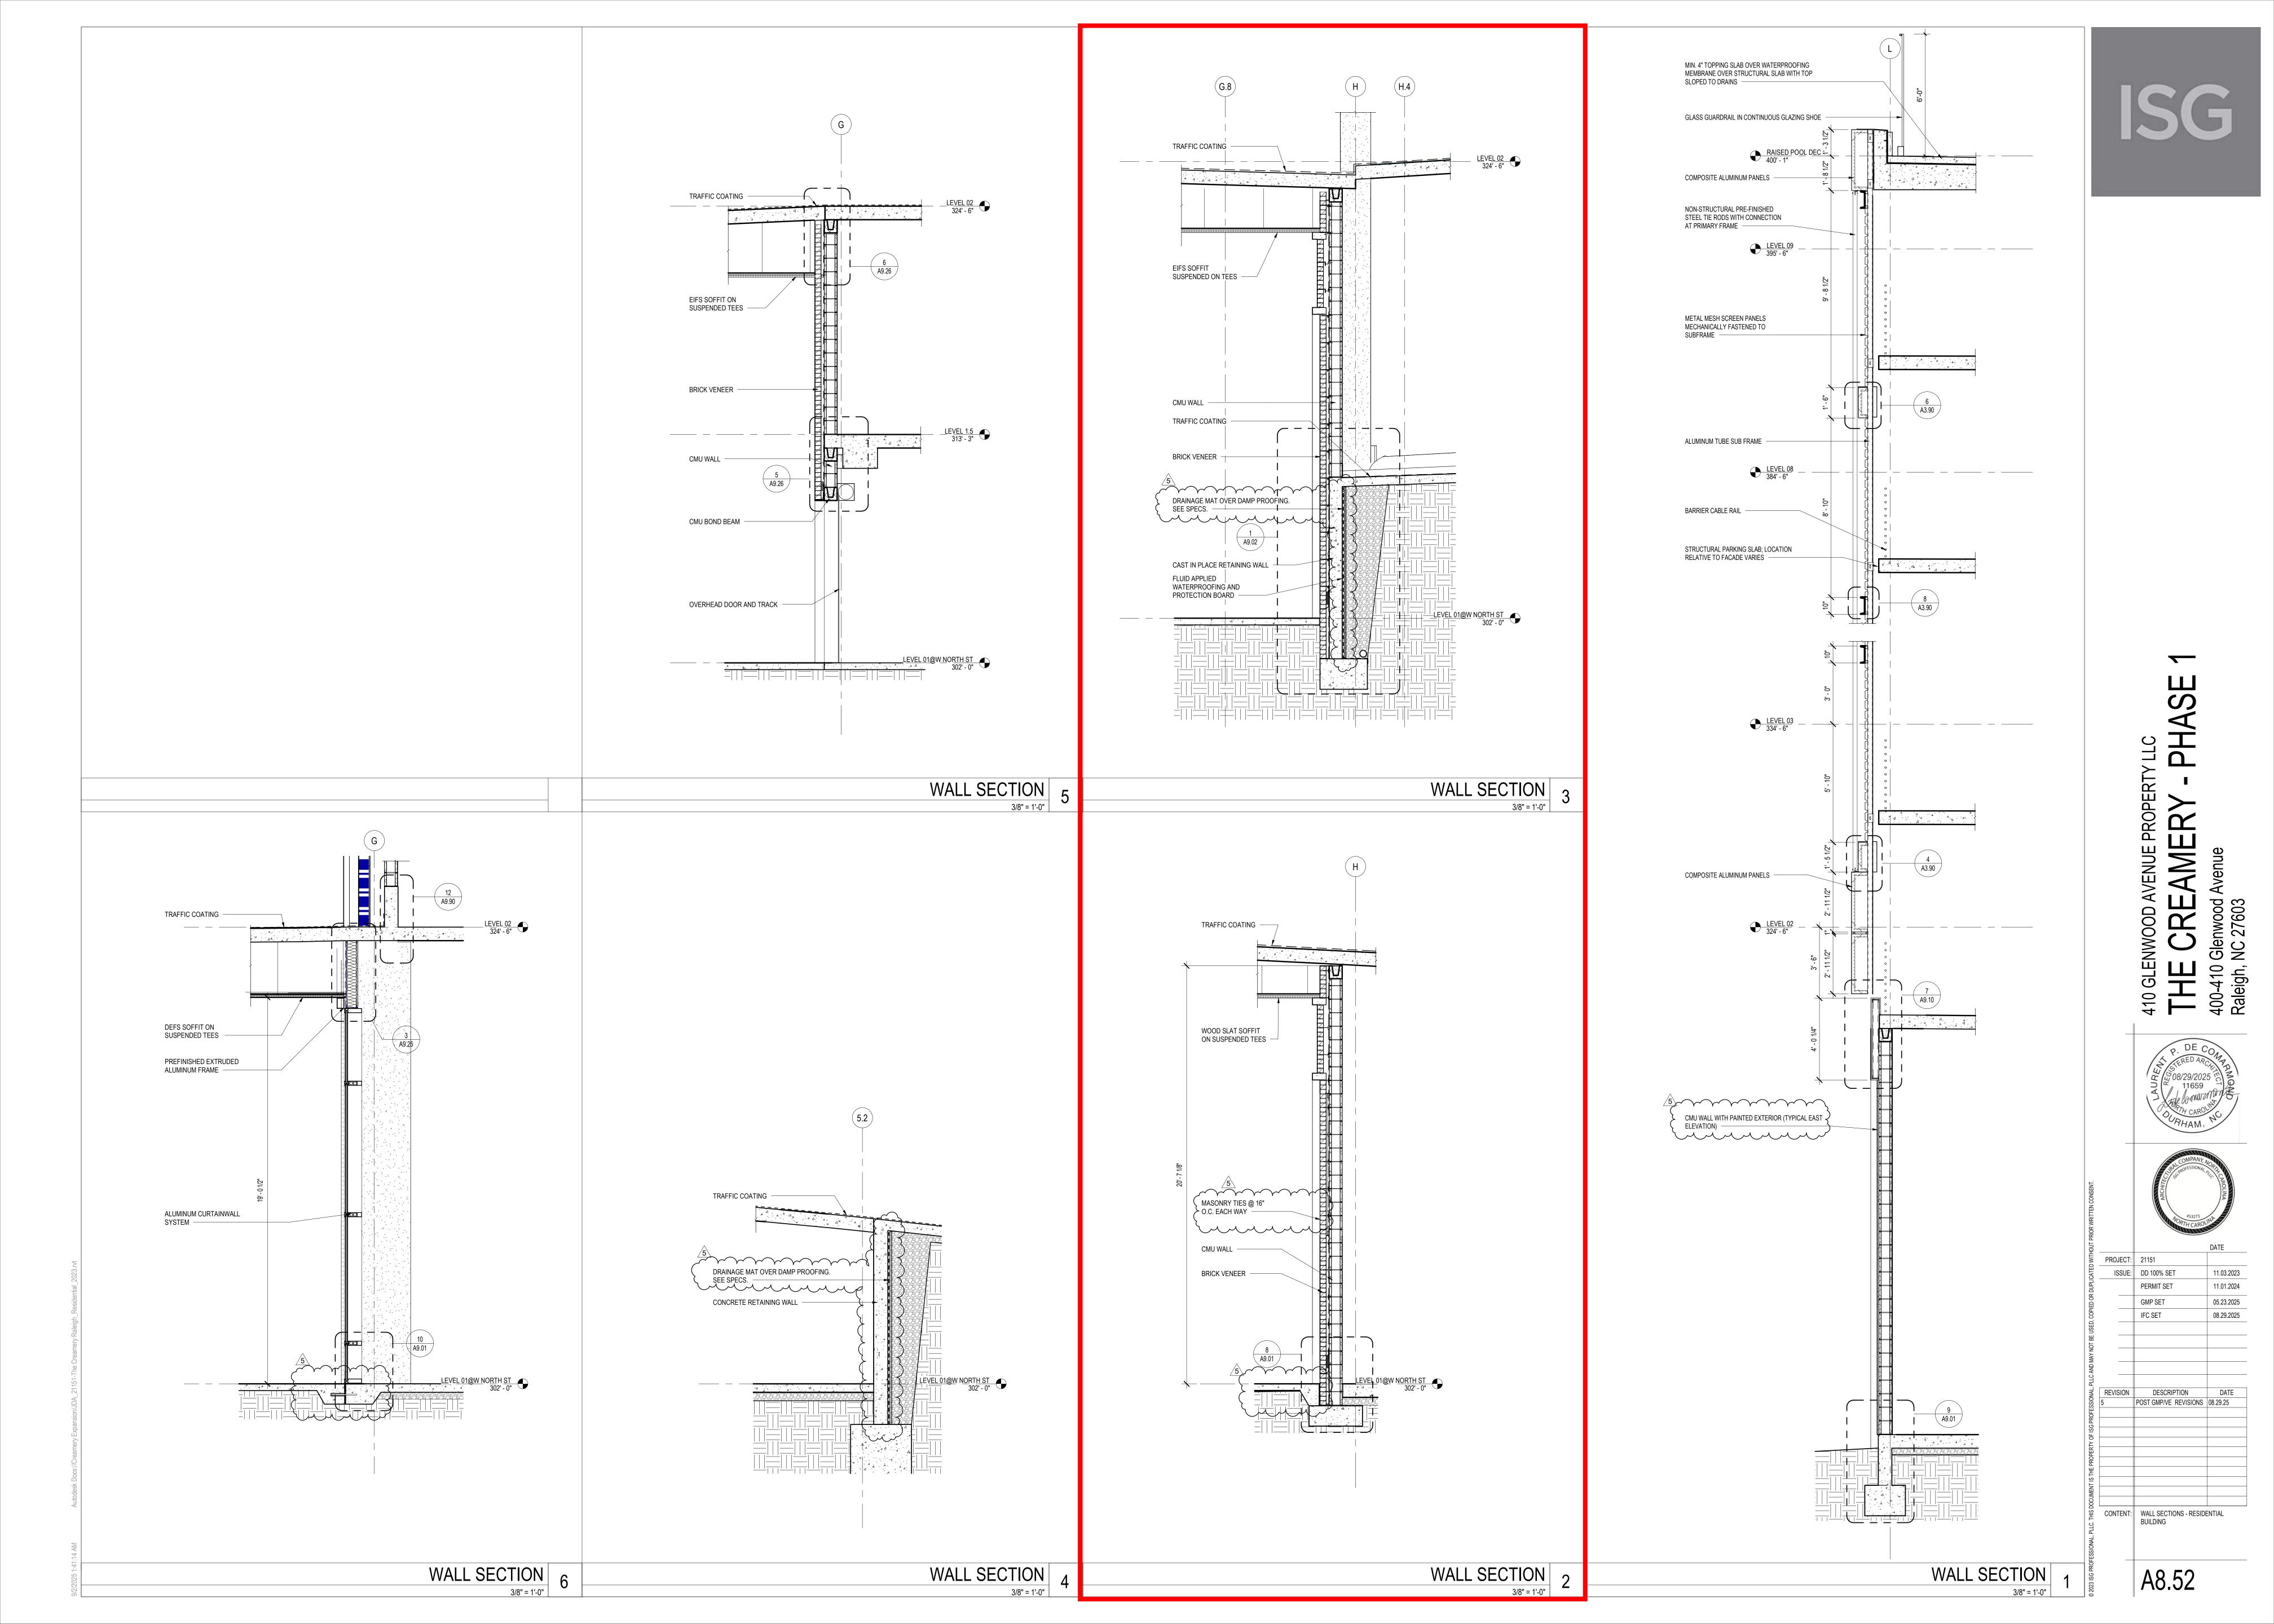

#### Material/Detail Modifications at the Loggia

#### Summary of street level modifications at the loggia (north side of residential building):

- 1. Minimal modifications to the loggia include:
  - The precast concrete frame and the five associated bay sizes remain consistent with the previously-approved COA. The details of the precast loggia columns remain consistent with the previously-approved COA.
  - To maximize the amount of glazing at the street level storefront, the signage band has been removed and the louver band required to meet HVAC requirements has been shifted from the building wall to the fascia. To accommodate the louvers while maintaining consistency with the massing and proportion of the previously-approved design, the parapet wall has been revised from steel railing to brick.
  - At the fascia, the previously-approved blue glazed brick has been revised to buff colored brick to match the new brick used elsewhere in the project.

#### Documentary materials and samples:

- 1. Side-by-side rendered elevations for the previously-approved and currently proposed elevation illustrates these modifications.
- 2. Architectural drawing 1/A3.72 illustrates a typical loggia bay and 4/A3.72 shows the storefront at the building wall behind the loggia. Architectural drawing 3/A3.72 illustrates the section cut through the loggia.
- 3. A graphic material key shows material colors and selections for the building. *Material samples and colors will be delivered to the RHDC office.*



Retail Loggia at Plaza **Precast Concrete** Glazed Brick


> Glenwood Avenue


#### **ELEVATION FROM APPROVED RHDC SUBMISSION**




PROPOSED ELEVATION

## Loggia Elevation

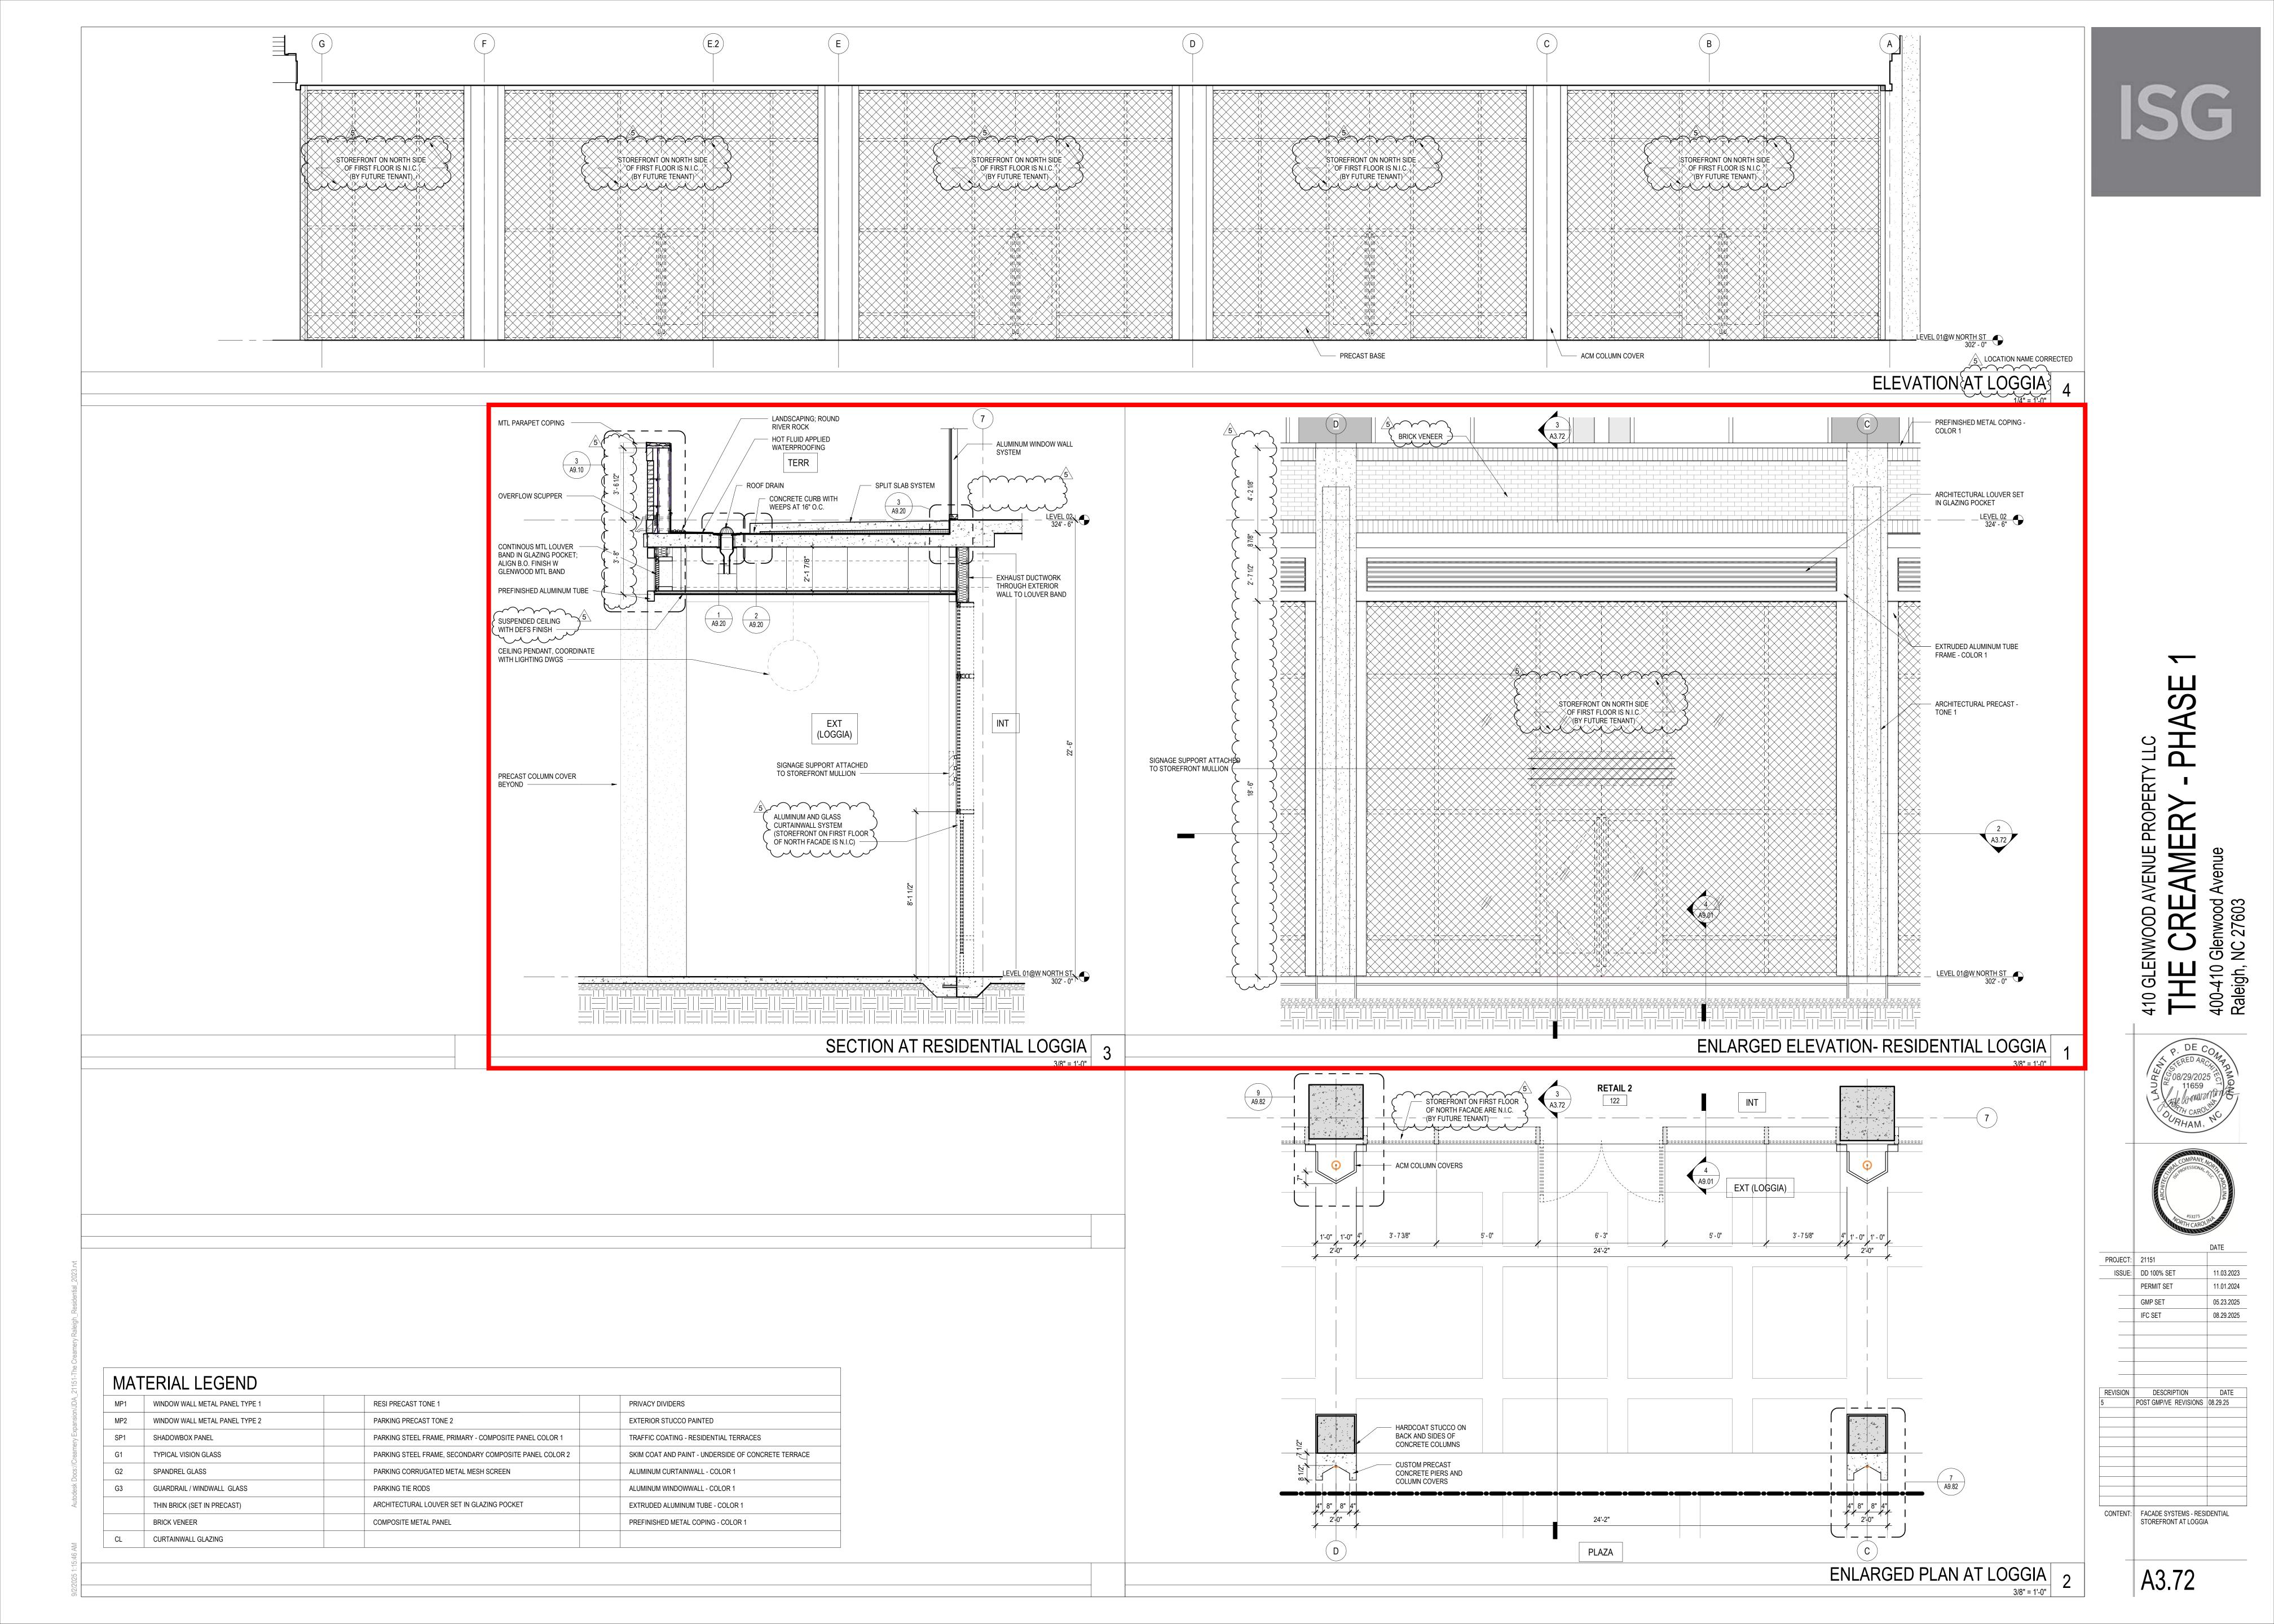

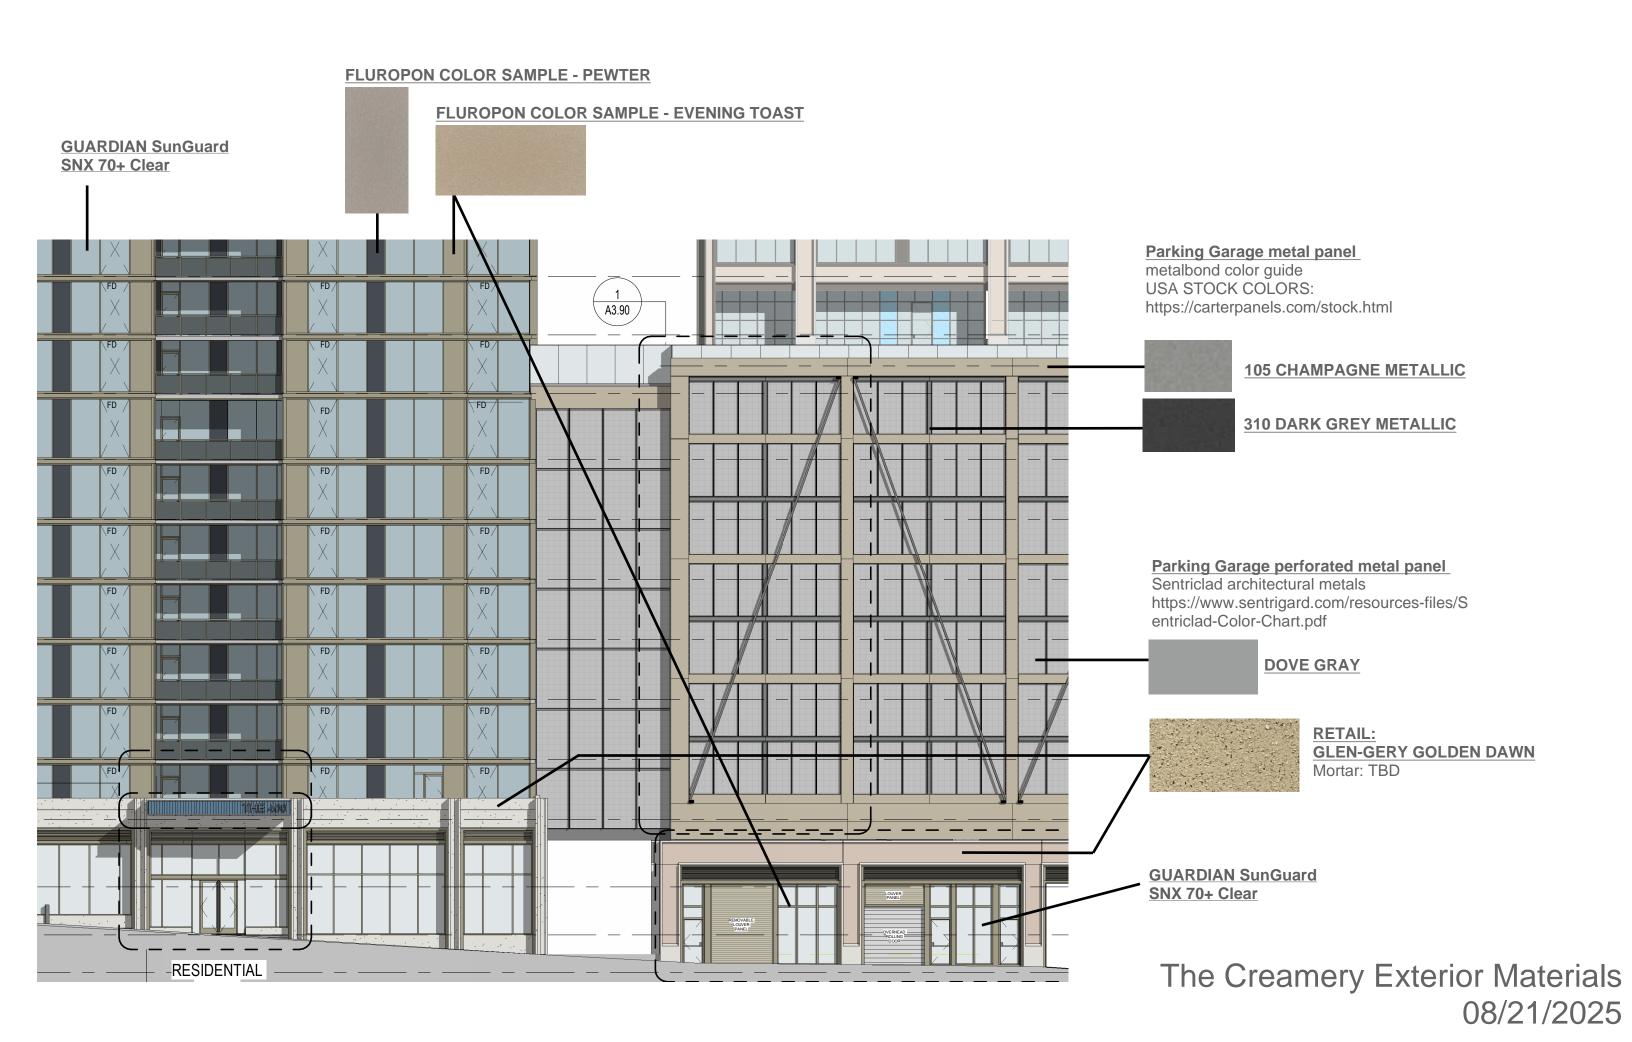

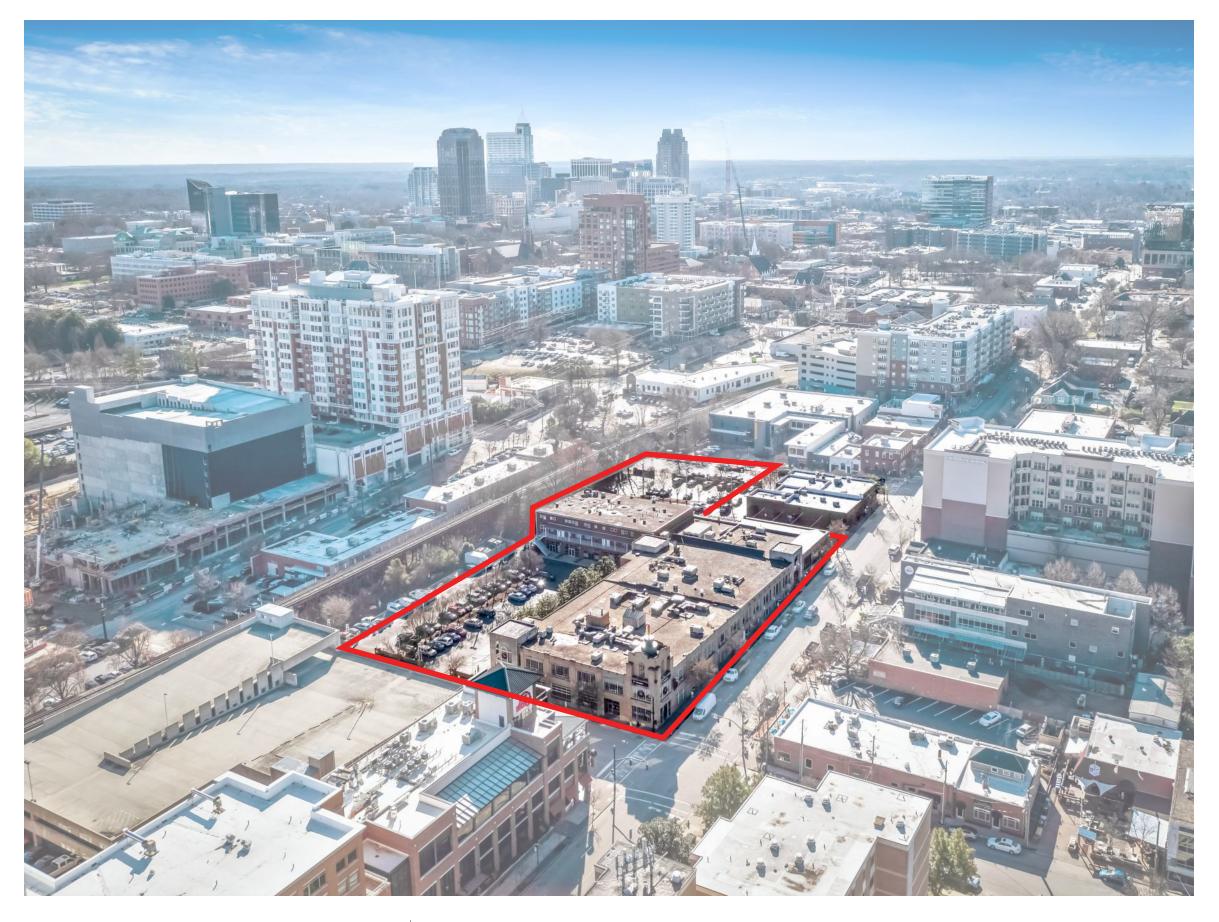










### Site Aerial View



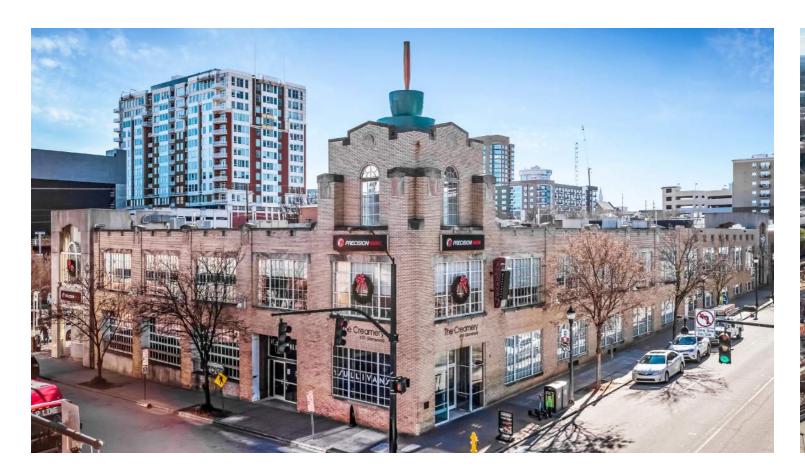

















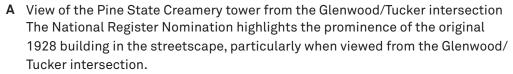



**B** View of Pine State Creamery looking south on Glenwood Avenue.

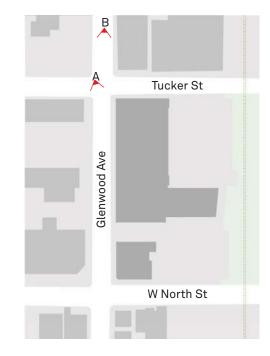











The Creamery, Raleigh, NC


COA Submission Phase 1: Massing & Stepback / 18 September 2020

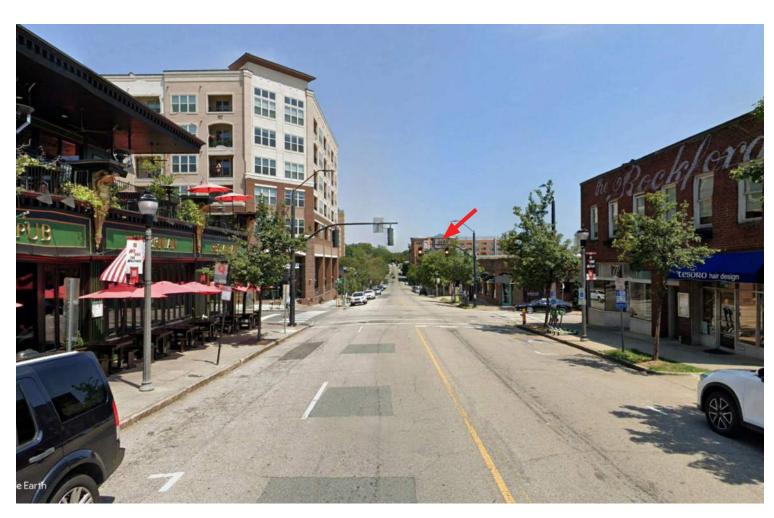

**C** View of Pine State Creamery looking north on Glenwood Avenue. The view of the Pine State Creamery when approaching from the south is obscured by the adjacent parcel (400 Glenwood) and by the zoning-required street trees.

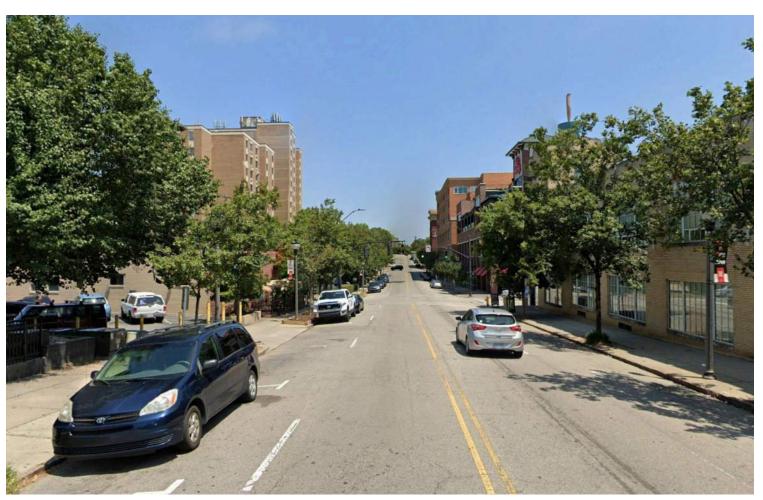

**D** View adjacent to Pine State Creamery looking north on Glenwood Avenue (West Elevation).

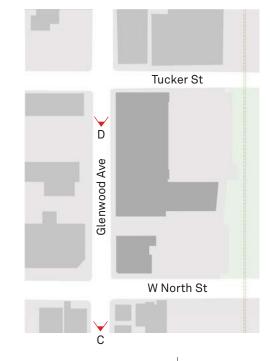












E View adjacent to Pine State Creamery looking east on Tucker Street (West Elevation) showing the prominence of the original 1928 building and tower at the corner of Glenwood Avenue and Tucker Street.



F View adjacent to Pine State Creamery looking east on Tucker Street (South Elevation).

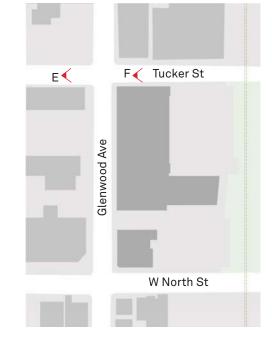










**G** View looking west down Tucker Street. The railroad bridge and embankment in the foreground obscures views of the Pine State Creamery building beyond.



H View of the surface parking lot adjacent to the Pine State Creamery looking west on Tucker Street (East Elevation). The historic 1928 portion is obscured by the 1998 addition.

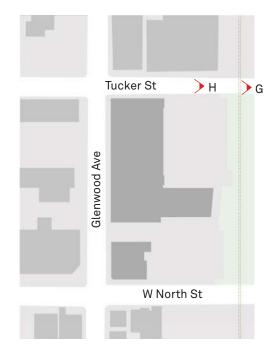










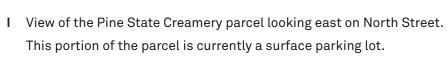



J View of the Pine State Creamery parcel looking west on North Street.

This portion of the parcel is currently a surface parking lot.

